

MISSISSIPPI DEPARTMENT OF NATURAL RESOURCES

Bureau of Land and Water Resources

Southport Mall

P.O. Box 10631

Jackson, Mississippi 39209

WATER WELL DRILLERS LOG

Rev. for STR

9/14/84

Qm

TUNICA
D 34

6-22-84
date well completed

Aester Drill
firm name

Tunica
county well located

LANDOWNER:	description of formations encountered	from	to
Scott Arnold Farms Tunica (mailing address)	Gumbo clay fine sand course sand GRAVEL	0 48 58	48 58 100
WELL LOCATION: sec. 13 T 8 N R 11 E 40 5 5 miles N/E of Tunica (distance) (direction) (nearest town)			
WELL PURPOSE: (home, irrigation, municipal, industrial)			
WELL COMPLETION DATA:			
(1) diameter (inches) 12			
(2) total depth (feet) 100			
(3) static water level (feet) 15 below top of ground.			
(4) casing 12 60 (material) (depth)			
(size) if telescope see back.			
(5) screen 40 60 (length) (depth to top)			
12 steel (size) (material)			
(6) pump 60 2000 (HP) (yield gpm)			
Power Unit (type power)			
(7) electric log No (yes or no)			
(organization running log)			
(8) how well bottom plugged			
DRILLERS REMARKS:			

CODED


CODED

DEPT. OF NATURAL RESOURCES
BUREAU OF LAND & WATER RESOURCES

SEP 12 1984
RECEIVED

If well telescopes please sketch and show depths.

GROUND LEVEL

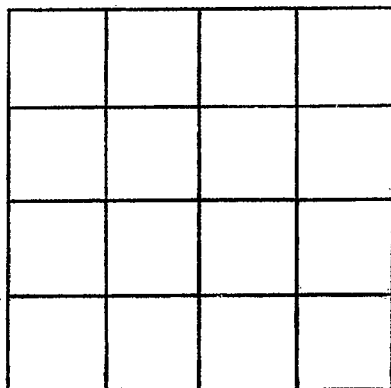

SECTION _____

Please indicate well location X.

ADDITIONAL INFORMATION

If more than one screen,
show locations of each on sketch.