

MISSISSIPPI DEPARTMENT OF NATURAL RESOURCES

Bureau of Land and Water Resources

Southport Mall

P.O. Box 10631

Jackson, Mississippi 39209

WATER WELL DRILLERS LOG

CODED

TUNICA
D 35

6-19-84 19
date well completed

Hestee Drilling Tunica
firm name county well located

LANDOWNER: Scott Arnold
FARMS
TUNICA
(mailing address)

description of formations encountered	from	to
Combo Clay	0	47
Fine SAND	47	55
Coarse SAND	55	100
GRAVEL		

WELL LOCATION:
sec. 13 T 5 N R 11 E
5 miles NNE of Tunica
(distance) (direction) (nearest town)

WELL PURPOSE: IRRIGATION
(home, irrigation, municipal, industrial)

- WELL COMPLETION DATA:
- (1) diameter (inches) 12
 - (2) total depth (feet) 100
 - (3) static water level (feet) 18 below above top of ground.
 - (4) casing Steel 60 (material) (depth)
 - (size) If telescope see back.
 - (5) screen 40 60 (length) (depth to top)
 - 12 Steel (size) (material)
 - (6) pump 60 2000 (HP) (yield gpm)
 - Power Unit (type power)
 - (7) electric log NO (yes or no)
 - (organization running log)
 - (8) how well bottom plugged Steel cap

CODED


DEPT. OF NATURAL RESOURCES
BUREAU OF LAND & WATER RESOURCES

SEP 15 1984
RECEIVED

DRILLERS REMARKS:

If well telescopes please sketch and show depths.

GROUND LEVEL

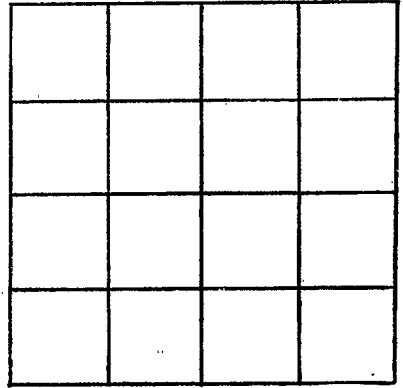

SECTION _____

Please indicate well location X.

ADDITIONAL INFORMATION

If more than one screen,
show locations of each on sketch.