

MISSISSIPPI DEPARTMENT OF NATURAL RESOURCES

Bureau of Land and Water Resources

Southport Mall

P.O. Box 10631

Jackson, Mississippi 39209

WATER WELL DRILLERS LOG

CODED

TUNICA  
D 36

6-15-84 19  
date well completed

Hester Drill  
firm name

TUNICA  
county well located

LANDOWNER: Scott Arnold  
Farms  
Tunica  
(mailing address)

description of formations encountered	from	to
<del>CLAY</del>		
Gumbo clay	0	48
fine sand	48	56
course sand + gravel	56	103

WELL LOCATION:  
sec. 13 T. 5 N. R. 11 E.  
5 miles N/E of Tunica  
(distance) (direction) (nearest town)

WELL PURPOSE: IRRIGATION  
(home, irrigation, municipal, industrial)

- WELL COMPLETION DATA:
- (1) diameter (inches) 12"
  - (2) total depth (feet) 103
  - (3) static water level (feet) 15 below above top of ground.
  - (4) casing Steel, 63  
(material) (depth)
  - \_\_\_\_\_ If telescope see back.  
(size)
  - (5) screen 40', 63  
(length) (depth to top)
  - 12", Steel  
(size) (material)
  - (6) pump 60, 2000  
(HP) (yield gpm)
  - Power Unit  
(type power)
  - (7) electric log no  
(yes or no)
  - \_\_\_\_\_ (organization running log)
  - (8) how well bottom plugged Steel cap

DRILLERS REMARKS: \_\_\_\_\_


CODED

DEPT. OF NATURAL RESOURCES  
BUREAU OF LAND & WATER RESOURCES

SEP 12 1984  
RECEIVED

If well telescopes please sketch and show depths.

GROUND LEVEL

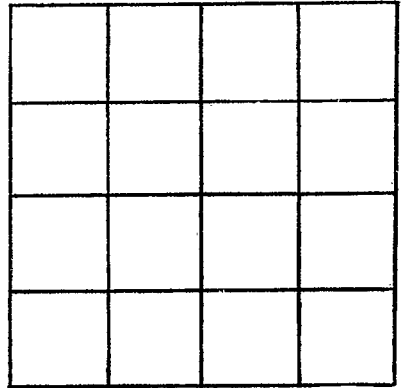

SECTION \_\_\_\_\_

Please indicate well location X.

ADDITIONAL INFORMATION

If more than one screen,  
show locations of each on sketch.