

MISSISSIPPI DEPARTMENT OF NATURAL RESOURCES

Bureau of Land and Water Resources

Southport Mall

P.O. Box 10631

Jackson, Mississippi 39209

WATER WELL DRILLERS LOG

~~DESO~~
TUNICA
 22-3596
D 38

Coded

~~DESO~~ TUNICA

7-20 19 87 LAYNE-CENTRAL CO. firm name county well located

LANDOWNER:	description of formations encountered	from	to
BLYTHE PLNTG.	CLAY	0	7
WALLS, MS	SAND	7	35
(mailing address)	SAND GRAVEL	35	107
WELL LOCATION:			
sec. <u>11</u> T. <u>4</u> N. R. <u>11</u> W.			
<u>2</u> miles E HOLLYWOOD			
(distance) (direction) of (nearest town)			
WELL PURPOSE: IRRIGATION			
(home, irrigation, municipal, industrial)			
WELL COMPLETION DATA:			
(1) diameter (inches) <u>10"</u>			
(2) total depth (feet) <u>107'</u>			
(3) static water level (feet) <u>19'</u> below top of ground.			
(4) casing <u>STEEL</u> <u>64'</u>			
(material) (depth)			
<u>10"</u> if telescope see back.			
(size)			
(5) screen <u>40'</u> <u>64'</u>			
(length) (depth to top)			
<u>10"</u> <u>ST. STEEL</u>			
(size) (material)			
(6) pump <u>40</u> <u>900</u>			
(HP) (yield gpm)			
<u>DIESEL</u>			
(type power)			
(7) electric log <u>NO</u>			
(yes or no)			
(organization running log)			
(8) how well bottom plugged <u>ST. PLATE</u>			

RECEIVED


MAY 09 1929

Department of Natural Resources
 Bureau of Land & Water Resources

DRILLERS REMARKS:

If well telescopes please sketch and show depths.

GROUND LEVEL

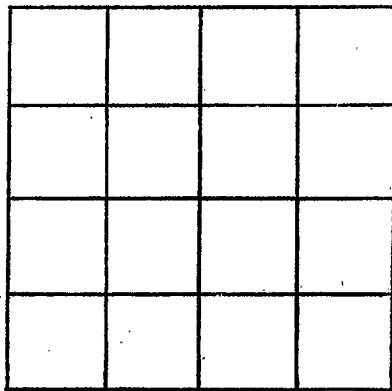

SECTION _____

Please indicate well location X.

ADDITIONAL INFORMATION

If more than one screen, show locations of each on sketch.