

MISSISSIPPI DEPARTMENT OF NATURAL RESOURCES

Bureau of Land and Water Resources

Southport Mall

P.O. Box 10631

CODED

Jackson, Mississippi 39209

WATER WELL DRILLERS LOG

Tunica  
D 102  
9/7/82

9-7 1982 Hester Drilling Tunica  
 date well completed firm name county well located

LANDOWNER: Chas Bery  
Tunica, Miss  
 (mailing address)

WELL LOCATION:  
 sec. 4 T. 4 N. R. 11 E  
6 1/2 miles NE of Tunica  
 (distance) (direction) (nearest town)

WELL PURPOSE: Dom  
 (home, irrigation, municipal, industrial)

WELL COMPLETION DATA:

(1) diameter (inches) 8"  
 (2) total depth (feet) 103  
 (3) static water level (feet) 12' below above top of ground.  
 (4) casing Plastic 63 ft  
 (material) (depth)  
NA if telescope see back.  
 (size)  
 (5) screen 40 ft 40 ft  
 (length) (depth to top)  
8" plate  
 (size) (material)  
 (6) pump 15 1100  
 (HP) (yield gpm)  
Elect  
 (type power)  
 (7) electric log no  
 (yes or no)  
no  
 (organization running log)

description of formations encountered	from	to
<u>Lunke</u>	<u>0</u>	<u>22</u>
<u>Sept. Mud</u>	<u>22</u>	<u>40</u>
<u>fine sand</u>	<u>40</u>	<u>52</u>
<u>Coarse sand</u>	<u>52</u>	<u>103</u>
<u>Gravel</u>		

CODED

(8) how well bottom plugged plastic cup

DRILLERS REMARKS: Well Good


DEPT. OF NATURAL RESOURCES  
 BUREAU OF LAND & WATER RESOURCES

SEP 30 1982

RECEIVED

If well telescopes please sketch and show depths.

GROUND LEVEL

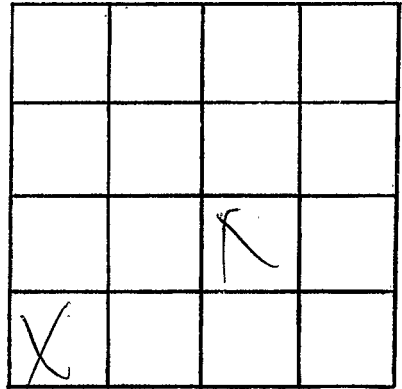

SECTION \_\_\_\_\_

Please indicate well location X.

ADDITIONAL INFORMATION

If more than one screen, show locations of each on sketch.