

WELL # 1 OF FIVE WELLS

Tunica
E7
3-67

MISSISSIPPI
BOARD OF WATER COMMISSIONERS
416 North State Street
Jackson, Mississippi 39201

CODED

WATER WELL DRILLERS LOG

3-6-1967 date well completed ABEL WELL SUPPLY CO firm name TUNICA county well located

LANDOWNER:

RICHARD HUSSEY
TUNICA MISS.
(mailing address)

description of formations encountered

from to

CLAY 1' 0'
BLACK SHOT 6' 20'
GUMBO CLAY 20' 38'
MED. TO COARSE SAND 35' 60'
COURSE SAND HEAVY GRAVEL 60' 100'

WELL LOCATION:

sec. 1 T. 4 S. R. 10 W.
Approx 10 miles NE of Tunica
(distance) (direction) (nearest town)

WELL PURPOSE:

IRRIGATION
(home, irrigation, municipal, industrial)

CODED

WELL COMPLETION DATA:


- (1) diameter (inches) 10 3/4 OD
- (2) total depth (feet) 108'
- (3) static water level (feet) 6 below top of ground.
- (4) casing 10 3/4" 250' (material), 78' (depth)
- (size) if telescope see back.
- (5) screen 30' (length), 78' (depth to top)
- 10 3/4" OD, W.W. SS WIRE RP (size) (material)
- (6) pump 50 (HP), 1200 AT 240' (yield gpm)

BUTANE GAS (type power)

(7) electric log NO (yes or no)

(organization running log)

(8) how well bottom plugged STEEL

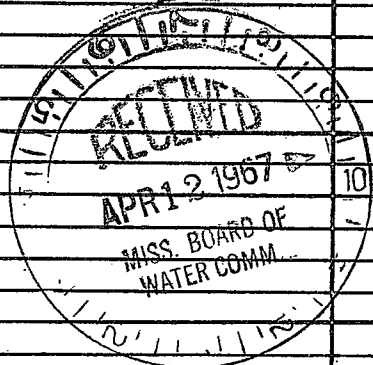


DRILLERS REMARKS:

BLACK SHOT WHEN DRILLING NEED APPROX 25 or 30' OF LACE CASING

If well telescopes please sketch and show depths.

GROUND LEVEL

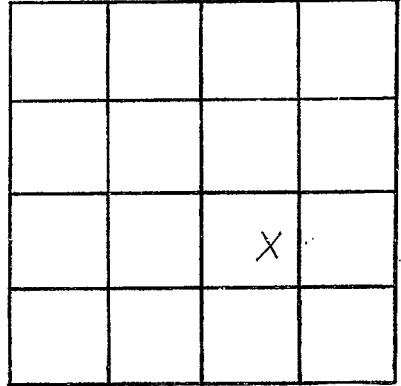

SECTION 1

Please indicate well location X.

ADDITIONAL INFORMATION

If more than one screen, show locations of each on sketch.