

WELL # 2 OF 5 WELLS

MISSISSIPPI
BOARD OF WATER COMMISSIONERS
416 North State Street
Jackson, Mississippi 39201

CODED

WATER WELL DRILLERS LOG

Tunica
E 8
3-67

3-9-1967 date well completed
 MISSISSIPPI WATER WELL SUPPLY CO firm name
 Tunica county well located

LANDOWNER:

RICHARD WUSSEY

description of formations encountered

from to

Tunica Miss. (mailing address)

CLAY 1' 6'
~~CLAY~~ BECK SHOES 6' 22'
 CLAY 22' 35'
~~CLAY~~ BED TO COARSE SAND 35' 60'
 COARSE SAND + HEAVY GRASS 60' 108'

WELL LOCATION:

sec. 12 T. 14 S. R. 10 W.
 APPROX 10 miles NE of Tunica
 (distance) (direction) (nearest town)

WELL PURPOSE: IRRIGATION (home, irrigation, municipal, industrial)

WELL COMPLETION DATA:

- (1) diameter (inches) 10 3/4" OD
- (2) total depth (feet) 108'
- (3) static water level (feet) 6' below top of ground.
- (4) casing 250 WOOD (material), 78' (depth)

CODED

- (5) screen 30' (length), 78' (depth to top)
- 10 3/4" OD, SS. WIRE WRAPPED PF (size) (material)


- (6) pump 90 (HP), 1200 @ 240' TDH (yield gpm)

BUTANE GAS (type power)

- (7) electric log NO (yes or no)

(organization running log)

- (8) how well bottom plugged STEEL

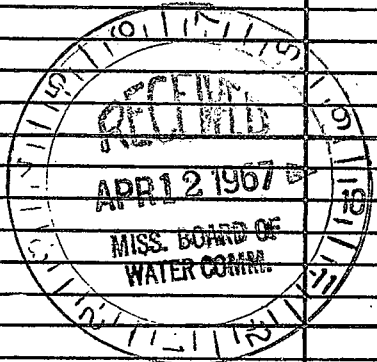

DRILLERS REMARKS: BECK SHOES RUNS BAD WHEN DRILLING NEED TO SET 25' OR 30' OF SURFACE CASING

If well telescopes please sketch and show depths.

GROUND LEVEL

		X	

SECTION 12

Please indicate well location X.

ADDITIONAL INFORMATION

If more than one screen, show locations of each on sketch.