

Junica
E 12
4-1-69

MISSISSIPPI
BOARD OF WATER COMMISSIONERS
416 North State Street
Jackson, Mississippi 39201

CODED

WATER WELL DRILLERS LOG

April 1 1969 Shelly Meyman Junica
date well completed firm name county well located

LANDOWNER: E. J. McCain

Route 2
Junica, Miss.
(mailing address)

WELL LOCATION:

sec. 20 T. 4 N. R. 10 E.
S W
2 miles N W of Prichard
(distance) (direction) (nearest town)

WELL PURPOSE: Home
(home, irrigation, municipal, industrial)

WELL COMPLETION DATA:

- (1) diameter (inches) 2
- (2) total depth (feet) 70
- (3) static water level (feet) 14 below top of ground.
- (4) casing Galvanne (material) 7 (depth)
- (size) if telescope see back.
- (5) screen 6 ft (length) (depth to top)
- 1/4" (size) (material)
- (6) pump 1 (HP) 16 (yield gpm)
- Electric (type power)
- (7) electric log No (yes or no)
- no (organization running log)
- (8) how well bottom plugged Rubber Seal

description of formations encountered	from	to
Black Clay	0	10
Sandy Soil	10	50
Clear Grey Sand	50	70

CODED


MAY 26 1969

DRILLERS REMARKS:

MISS. BD. OF
WATER COMMISSIONERS

If well telescopes please sketch and show depths.

GROUND LEVEL

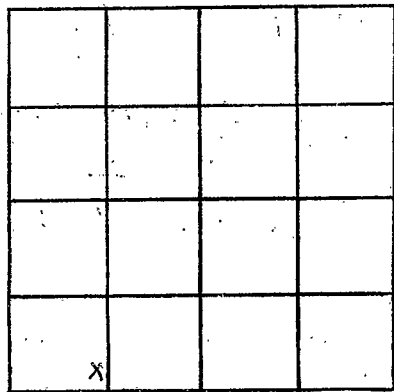

WELL SECTION 20

Please indicate well location X.

ADDITIONAL INFORMATION

If more than one screen, show locations of each on sketch.