

Tunica
E 14
5-12-69

MISSISSIPPI
BOARD OF WATER COMMISSIONERS
416 North State Street
Jackson, Mississippi 39201

CODED
CODED

WATER WELL DRILLERS LOG

5-12 1969 Jim Renix Tunica
date well completed firm name county well located

LANDOWNER: James E. Daniel

description of formations encountered	from	to
	Dirt	0
Sand & Gravel	20	66

Rt. 2. Box 59

Tunica, Miss.
(mailing address)

WELL LOCATION:
sec. 15 T. 4 # 10 #
 S R E
 W
10 miles East of Tunica
(distance) (direction) (nearest town)

WELL PURPOSE: Home
(home, irrigation, municipal, industrial)

WELL COMPLETION DATA:

(1) diameter (inches) 2 "
(2) total depth (feet) 66
(3) static water level (feet) 25 ^{#/V/V/V} above
top of ground Galv.

(4) casing 1 1/2" 62
(material) (depth)
 If telescope see back.
(size)

(5) screen 48" 62
(length) (depth to top)
1 1/2" Brass
(size) (material)

(6) pump
(HP) (yield gpm)

(type power)

(7) electric log
(yes or no)

(organization running log)


(8) how well bottom plugged

CODED

MAY 24 1969
MISS. BD. OF
WATER COMM.

DRILLERS REMARKS:
Owner Installed Pump

If well telescopes please sketch and show depths.

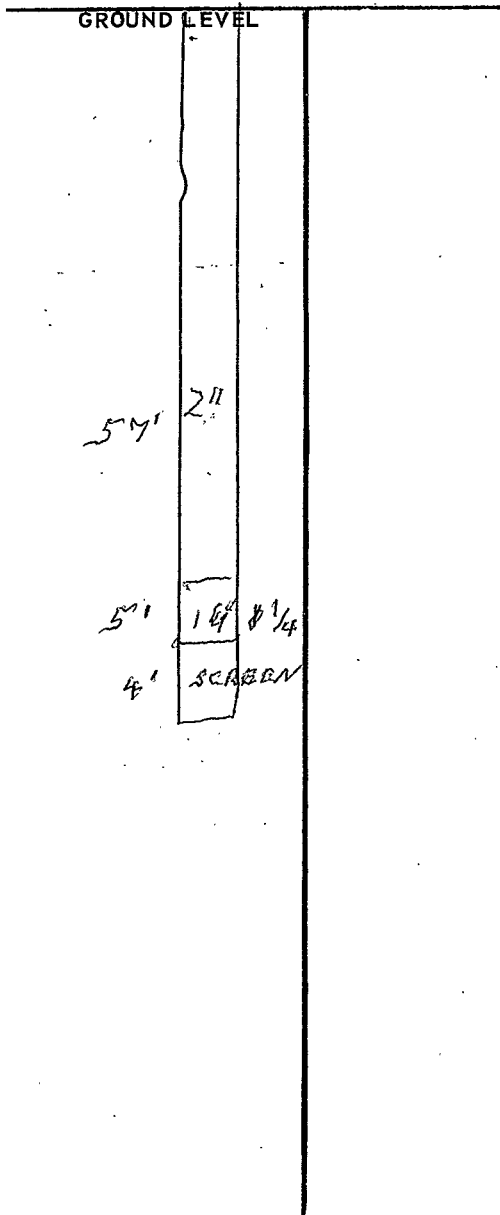

			X

SECTION 15

Please indicate well location X.

ADDITIONAL INFORMATION

If more than one screen, show locations of each on sketch.