

Tunica
E 15
1-70

MISSISSIPPI
BOARD OF WATER COMMISSIONERS
416 North State Street
Jackson, Mississippi 39201

WATER WELL DRILLERS LOG

COPIED

1-10
date well completed

1920 JIM-RENIX
firm name

TUNICA
county well located

LANDOWNER: DAN-CURRY
RT-1. BOX 1687
ROBINSONVILLE, MISS-
(mailing address)

description of formations encountered	from	to
CLAY	0	30
CLAY & SAND	30	60
SAND -	60	71

WELL LOCATION:
sec. 10 T 4 R 10 E
3 miles NORTH of DRUMMOID
(distance) (direction) (nearest town)

WELL PURPOSE: HOME
(home, irrigation, municipal, industrial)

- WELL COMPLETION DATA:
- (1) diameter (inches) 2 IN
 - (2) total depth (feet) 71
 - (3) static water level (feet) 20 below above top of ground.
 - (4) casing GALV. PIPE - 67 (material) (depth)
2" x 1/4" telescope see back. (size)
 - (5) screen 4' 67 (length) (depth to top)
1/4" BRASS (size) (material)
 - (6) pump (HP) (yield gpm)
(type power)
 - (7) electric log (yes or no)
(organization running log)
 - (8) how well bottom plugged



DRILLERS REMARKS:
NUMBER - INSTALLED - PUMP

FEB 4 1970

MISS. BD. OF
WATER COMM.

If well telescopes please sketch and show depths.

GROUND LEVEL

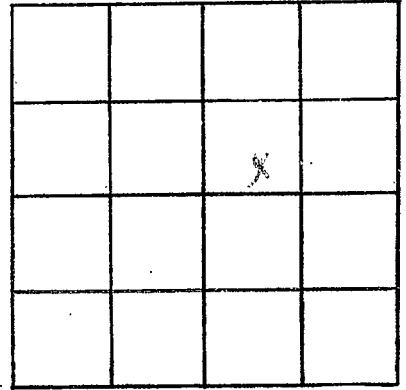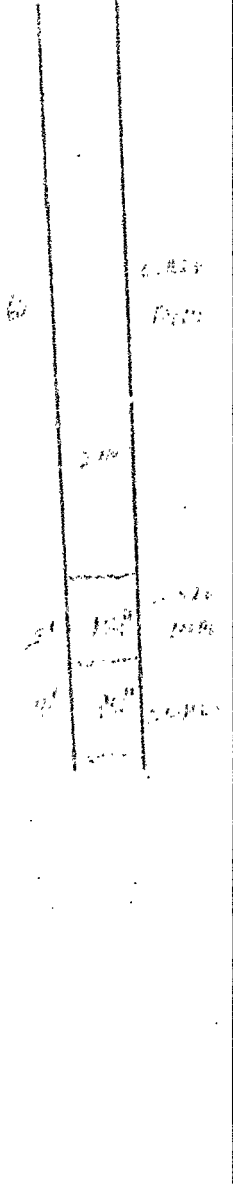

SECTION 10

Please indicate well location X.

ADDITIONAL INFORMATION

Multiple horizontal lines for additional information.

If more than one screen, show locations of each on sketch.