

TUNICA  
E 16  
8-2-70

MISSISSIPPI  
BOARD OF WATER COMMISSIONERS  
416 North State Street  
Jackson, Mississippi 39201

CODED

WATER WELL DRILLERS LOG

Aug 2 1970 Shelby Deppas Tunica  
date well completed firm name county well located

LANDOWNER: <u>Mr. H. J. Cortey</u>	description of formations encountered	from	to
<u>Richard Miss 38660</u> (mailing address)	<u>Black Clay</u>	0	10
WELL LOCATION:	<u>Grey Clay</u>	10	20
sec. <u>27</u> T. <u>4</u> R. <u>10</u> <u>in town of Richard</u> (distance) <u>5</u> miles (direction) <u>S</u> of (nearest town)	<u>Blue Sand</u>	20	60
WELL PURPOSE: <u>Home</u> (home, irrigation, municipal, industrial)	<u>Clear Grey Sand</u>	60	73
WELL COMPLETION DATA:			
(1) diameter (inches) <u>2</u>			
(2) total depth (feet) <u>73</u>			
(3) static water level (feet) <u>18</u> <u>below</u> top of ground.			
(4) casing <u>Galvne</u> <u>63</u> (material) (depth)			
____ (size) if telescope see back.			
(5) screen <u>5ft</u> (length) (depth to top)			
<u>1 1/2</u> <u>Standard Steel</u> (size) (material)			
(6) pump <u>1/2</u> <u>12</u> (HP) (yield gpm)			
<u>Electric</u> (type power)			
(7) electric log <u>No</u> (yes or no)			
____ (organization running log)			
(8) how well bottom plugged <u>Rubber Seal</u>			
DRILLERS REMARKS:			


CODED

SEP 14 1970

MISS. BD. OF  
WATER COMMISSIONERS

If well telescopes please sketch and show depths.

GROUND LEVEL

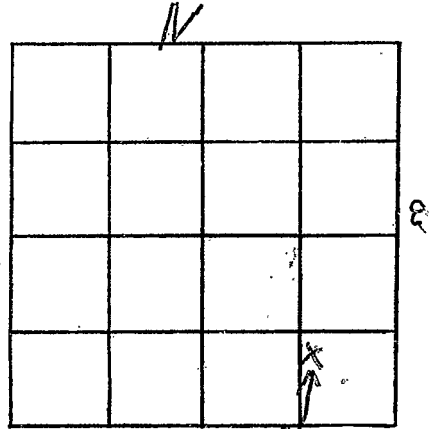

SECTION 27

Please indicate well location X.

ADDITIONAL INFORMATION

If more than one screen,  
show locations of each on sketch.