

TONICA  
E 17  
8-10-70

MISSISSIPPI  
BOARD OF WATER COMMISSIONERS  
416 North State Street  
Jackson, Mississippi 39201

**CODED**

WATER WELL DRILLERS LOG

Aug 10 1970 Shelby Meyman Tunica  
date well completed firm name county well located

LANDOWNER: Paul Hays  
P. O. Box 76  
Pritchard Miss  
(mailing address)

description of formations encountered

from	to
5	10
10	30
30	60
60	73

WELL LOCATION:

sec. 27 T. 4 N. R. 8 E  
In town of Pritchard  
(distance) (direction) (nearest town)

Black Clay  
Grey clay  
sandy  
Clear grey sand

WELL PURPOSE: home  
(home, irrigation, municipal, industrial)

WELL COMPLETION DATA:

- (1) diameter (inches) 2
- (2) total depth (feet) 73
- (3) static water level (feet) 18 below top of ground.
- (4) casing Galvanized (material) 63 (depth)  
(size) If telescope see back.
- (5) screen 5 ft (length) (depth to top)  
1/4" Stainless Steel (size) (material)
- (6) pump 1/2 (HP) 12 (yield gpm)  
Electric (type power)
- (7) electric log no (yes or no)  
(organization running log)
- (8) how well bottom plugged Rubber Seal


**CODED**

DRILLERS REMARKS:

SEP 14 1970

If well telescopes please sketch and show depths.

GROUND LEVEL

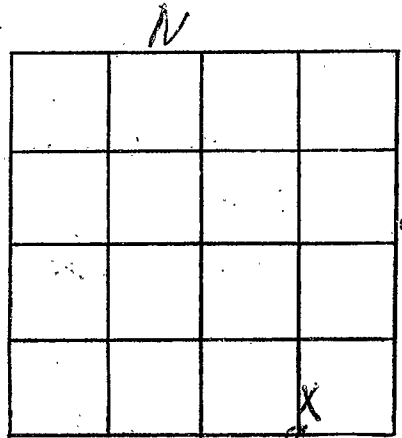

SECTION \_\_\_\_\_

Please indicate well location X.

ADDITIONAL INFORMATION

If more than one screen,  
show locations of each on sketch.