

TUNICA
E 18
10-67

MISSISSIPPI
BOARD OF WATER COMMISSIONERS
416 North State Street
Jackson, Mississippi 39201

CODED

WATER WELL DRILLERS LOG

TUNICA
De Soto

10-26-1967 Robert Wilson date well completed
firm name
county well located

LANDOWNER: J.M. Ashford
Eudora
Miss.
(mailing address)


description of formations encountered	from	to
Red clay	0	20
Red Sand White clay	20	30
Brown Sand	30	60
Brown Sand Blue clay	60	90

WELL LOCATION:
sec. 7 T. 4 N. R. 10 E.
miles Woodland lake
(distance) (direction) (nearest town)

WELL PURPOSE:
(home, irrigation, municipal, industrial)

- WELL COMPLETION DATA:
- (1) diameter (inches) 4"
 - (2) total depth (feet) 70'
 - (3) static water level (feet) 30' below top of ground
 - (4) casing Plastic 62' (material) (depth)
4" (size) if telescope see back.
 - (5) screen 8' 62' (length) (depth to top)
4" Gravel pack (size) (material)
 - (6) pump 1/2 10 (HP) (yield gpm)
Elast 2 (type power)
 - (7) electric log (yes or no)
(organization running log)
 - (8) how well bottom plugged 4"
flashed cap


CODED

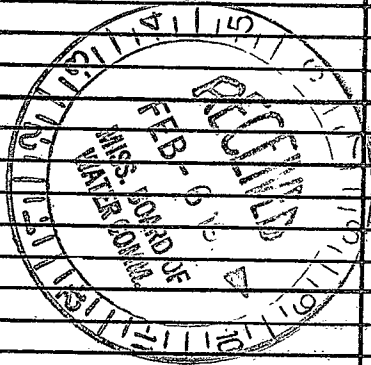

DRILLERS REMARKS:

If well telescopes please sketch and show depths.

GROUND LEVEL

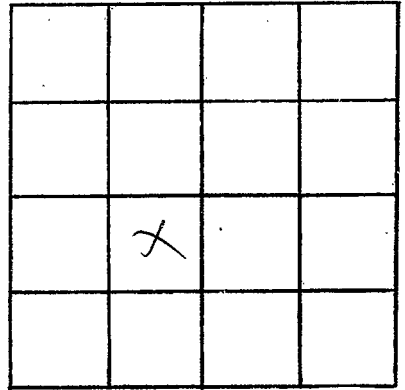

SECTION 2

Please indicate well location X.

ADDITIONAL INFORMATION

If more than one screen, show locations of each on sketch.