

TUNICA
E 20
1-30-74

MISSISSIPPI
BOARD OF WATER COMMISSIONERS
416 North State Street
Jackson, Mississippi 39201

CODED

WATER WELL DRILLERS LOG

Jan 30 1974 date well completed
Shelby Newman firm name
Tunica county well located

LANDOWNER: We, Jepsen
Prichard
Mississippi
(mailing address)

description of formations encountered	from	to
Blue Clay	0	20
Blue Sand	20	70
Clear Grey	70	90

WELL LOCATION:
sec 28 T 4 N R 10 E
2 1/2 miles West of PRICHARD
(distance) (direction) (nearest town)

WELL PURPOSE: Home
(home, irrigation, municipal, industrial)

- WELL COMPLETION DATA:
- (1) diameter (inches) 2
 - (2) total depth (feet) 20
 - (3) static water level (feet) 121 below top of ground.
 - (4) casing PVC 80 (material) (depth)
(size) If telescope see back.
 - (5) screen 20ft 60 (length) (depth to top)
2" PC (size) (material)
 - (6) pump 3/4 8 (HP) (yield-gpm)
(type power)
 - (7) electric log 20/60 (type of log)
(organization running log)
 - (8) how well bottom plugged PVC cap

CODED

MISSISSIPPI DISTRICT WATER


MAR 17 1974

MISS. BU. OF WATER COMMISSIONERS

DRILLERS REMARKS:

If well telescopes please sketch and show depths.

GROUND LEVEL

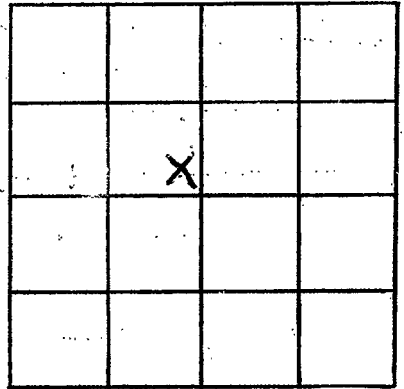

SECTION 28

Please indicate well location X.

ADDITIONAL INFORMATION

If more than one screen, show locations of each on sketch.