

TUNICA
E21
10-15-74

MISSISSIPPI
BOARD OF WATER COMMISSIONERS
416 North State Street
Jackson, Mississippi 39201

CODED

WATER WELL DRILLERS LOG

10-15-19 date well completed Hester Drilling Co. firm name Tunica county well located

LANDOWNER: Charles Barry
Tunica Miss
(mailing address)

description of formations encountered	from	to
clay	0	28
fine sand	28	56
coarse sand & gravel	56	110

WELL LOCATION:
sec. 3 T. 4 N. 5 R. 10 E. W
7 miles N of Richard
(distance) (direction) (nearest town)

WELL PURPOSE: RICE
(home, irrigation, municipal, industrial)

- WELL COMPLETION DATA:
- (1) diameter (inches) 16"
 - (2) total depth (feet) 110
 - (3) static water level (feet) 13 ^{below} _{above} top of ground.
 - (4) casing steel 70'
(material) (depth)
16" If telescope see back.
(size)
 - (5) screen 40' 70'
(length) (depth to top)
16" steel
(size) (material)
 - (6) pump 100 3000
(HP) (yield gpm)
DIESEL
(type power)
 - (7) electric log no
(yes or no)
 - (organization running log)
 - (8) how well bottom plugged Platc


DRILLERS REMARKS:

REGISTERED
OCT 29 1974

MISS. BD. OF WATER COMM

If well telescopes please sketch and show depths.

GROUND LEVEL

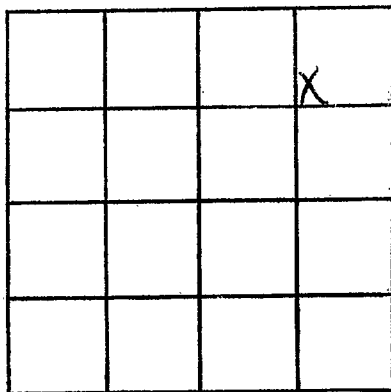

SECTION 3

Please indicate well location X.

ADDITIONAL INFORMATION

If more than one screen,
show locations of each on sketch.