

TUNICA
E22
10-22-74

MISSISSIPPI
BOARD OF WATER COMMISSIONERS
416 North State Street
Jackson, Mississippi 39201

WATER WELL DRILLERS LOG

CODED

10-22 date well completed 74 Houston Drilling Tunica firm name county well located

LANDOWNER: Charles Beard

Description of formations encountered

from to

| | | | |
|-------------|-------------|----|-----|
| Tunica Miss | clay | 0 | 15 |
| | fine sand | 15 | 40 |
| | coarse sand | 40 | 103 |

(mailing address)

WELL LOCATION:

sec. 14 T 4 N R 10 W
7 miles N of Richard
(distance) (direction) (nearest town)

WELL PURPOSE: RICE
(home, irrigation, municipal, industrial)

WELL COMPLETION DATA:

- (1) diameter (inches) 16"
- (2) total depth (feet) 103
- (3) static water level (feet) 12' below top of ground
- (4) casing steel, 63' (material) (depth)
16" if telescope see back. (size)
- (5) screen 10' 63' (length) (depth to top)
16" steel (size) (material)
- (6) pump 100 22000 (HP) (yield gpm)
DIRSK (type power)
- (7) electric log no (yes or no)

(organization running log)


(8) how well bottom plugged Plate

REGISTERED
OCT 23 1974
MISS. BD. OF WATER COMMISSIONERS

DRILLERS REMARKS:

If well telescopes please sketch and show depths.

GROUND LEVEL

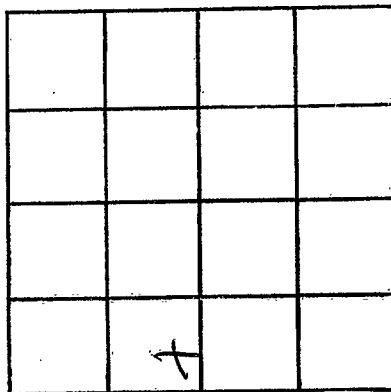

SECTION *JK*

Please indicate well location X.

ADDITIONAL INFORMATION

If more than one screen, show locations of each on sketch.