

TUNICA
E23
4-15-75

MISSISSIPPI
BOARD OF WATER COMMISSIONERS
416 North State Street
Jackson, Mississippi 39201

CODED

WATER WELL DRILLERS LOG

4-15-75 19 Hester Drilling Co Tunica
date well completed firm name county well located

LANDOWNER: H.C. Gindley
Tunica Miss

(mailing address)

WELL LOCATION:
sec 32 T 4 R 10 W
6 miles East of Tunica
(distance) (direction) (nearest town)

WELL PURPOSE: irrigation
(home, irrigation, municipal, industrial)

WELL COMPLETION DATA:

- (1) diameter (inches) 16
(2) total depth (feet) 116
(3) static water level (feet) 7 below
top of ground: above
(4) casing steel 76
(material) (depth)
16 If telescope see back.
(size)
(5) screen 40' 76
(length) (depth to top)
16 steel
(size) (material)
(6) pump 60 3000
(HP) (yield gpm)
Diesel
(type-power)
(7) electric log (yes or no)

(organization running log)

(8) how well bottom plugged Plate

DRILLERS REMARKS:

description of formations
encountered

from

to

Clay 0 39
fine sand 39 70
coarse sand & gravel 70 116

CODED


RECEIVED

APR 29 1975

MISS. BD. OF WATER COMMISSIONERS

If well telescopes please
sketch and show depths.

GROUND LEVEL

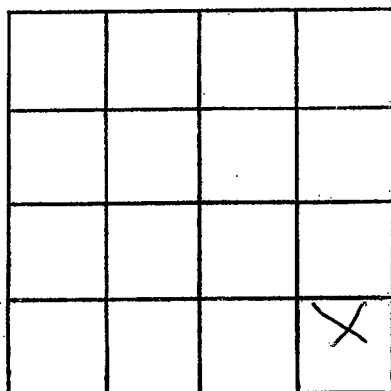

SECTION 32

Please indicate well location X.

ADDITIONAL INFORMATION

If more than one screen,
show locations of each on sketch.