

TUNICA  
E 24  
10-5-75

MISSISSIPPI  
BOARD OF WATER COMMISSIONERS  
416 North State Street  
Jackson, Mississippi 39201

WATER WELL DRILLERS LOG

10/5 1975 Hester Drilling Co Tunica  
date well completed firm name county well located

LANDOWNER: <u>Richard Hussay</u>	description of formations encountered	from	to
<u>Tunica Miss</u>			
(mailing address)	Clay	0'	28'
	Fine sand	28'	40'
	Coarse sand & gravel	40'	91'

WELL LOCATION:  
sec. 23 T. 4 N. R. 10 E  
2 1/2 miles NE of Pritchard  
(distance) (direction) (nearest town)

WELL PURPOSE: Irrigation  
(home, irrigation, municipal, industrial)

- WELL COMPLETION DATA:
- (1) diameter (inches) 1 1/2"
  - (2) total depth (feet) 91
  - (3) static water level (feet) 12 below/above top of ground
  - (4) casing steel, 51 (material) (depth)  
(size) if telescope see back.
  - (5) screen 40', 51' (length) (depth to top)  
16", steel (size) (material)
  - (6) pump 100 3000 (HP) (yield gpm)  
Diesel (type power)
  - (7) electric log no (yes or no)  
(organization running log)
  - (8) how well bottom plugged steel plate


REGISTERED  
OCT 16 1975

MISS. BD. OF WATER COMMISSIONERS

DRILLERS REMARKS:

If well telescopes please sketch and show depths.

GROUND LEVEL

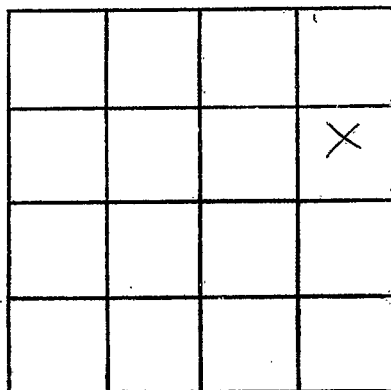

SECTION 23

Please indicate well location X.

ADDITIONAL INFORMATION

If more than one screen,  
show locations of each on sketch.