

Tunica
E29
5-22-81

MISSISSIPPI
BOARD OF WATER COMMISSIONERS
416 North State Street
Jackson, Mississippi 39201

WATER WELL DRILLERS LOG

5-22 1981 date well completed
Hester Drilling firm name
Tunica county well located

LANDOWNER: John & Mcathews
Robersonville, Miss (mailing address)

description of formations encountered	CODED	from	to
Shale		0	42
Stone Sand		42	59
Coarse sand & gravel		59	110

WELL LOCATION:
sec. 10 T. 4 N. R. 10 E
10 miles N. East of Tunica (distance) (direction) (nearest town)

WELL PURPOSE: Irra (home, irrigation, municipal, industrial)

- WELL COMPLETION DATA:
- (1) diameter (inches) 8 in
 - (2) total depth (feet) 110
 - (3) static water level (feet) 15 below top of ground.
 - (4) casing plastic 70 (material) (depth)
no If telescope see back. (size)
 - (5) screen 40 70 (length) (depth to top)
8 plastic (size) (material)
 - (6) pump 15 1100 (HP) (yield gpm)
Elast (type power)
 - (7) electric log no (yes or no)
no (organization running log)
 - (8) how well bottom plugged plastic cap.

CODED

DEPT. OF NATURAL RESOURCES
BUREAU OF LAND & WATER RESOURCES


MAY 28 1981

RECEIVED

DRILLERS REMARKS:

If well telescopes please sketch and show depths.

GROUND LEVEL

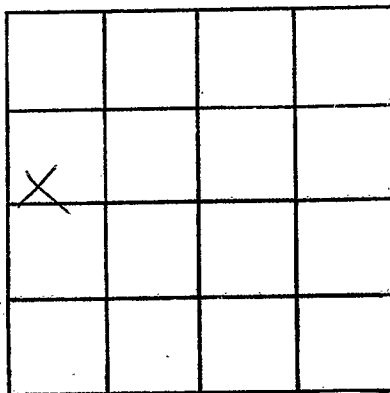

SECTION 10

Please indicate well location X.

ADDITIONAL INFORMATION

If more than one screen,
show locations of each on sketch.