

MISSISSIPPI DEPARTMENT OF NATURAL RESOURCES

Bureau of Land and Water Resources

Southport Mall

P.O. Box 10631

Jackson, Mississippi 39209

WATER WELL DRILLERS LOG

TUNICA  
E 30  
8-16-81

8-16 1981 Hester Drilby Tunica  
 date well completed firm name county well located

LANDOWNER: Jimmie Jepsod Farms  
Tunica, Miss  
 (mailing address)

description of formations encountered	from	to
<u>Clay</u>	<u>0</u>	<u>95</u>
<u>Hard Sand</u>	<u>25</u>	<u>47</u>
<u>Coarse Sand &amp; Gravel</u>	<u>42</u>	<u>199</u>

WELL LOCATION:  
7 sec 31 T 4 R 10  
0 7 miles N West of Tunica  
 (distance) (direction) (nearest town)

WELL PURPOSE: Dom  
 (home, irrigation, municipal, industrial)

WELL COMPLETION DATA:

(1) diameter (inches) 8"  
 (2) total depth (feet) 97  
 (3) static water level (feet) 2 below above top of ground.  
 (4) casing Plastic 57  
 (material) (depth)  
8 If telescope see back.  
 (size)  
 (5) screen 40 57  
 (length) (depth to top)  
8 Plastic  
 (size) (material)  
 (6) pump 10 700  
 (HP) (yield gpm)  
Chit  
 (type power)  
 (7) electric log no  
 (yes or no)  
no  
 (organization running log)  
 (8) how well bottom plugged Plastic  
Cap

DRILLERS REMARKS:


DEPT. OF NATURAL RESOURCES  
 BUREAU OF LAND & WATER RESOURCES

SEP - 9 1981

RECEIVED

If well telescopes please sketch and show depths.


GROUND LEVEL

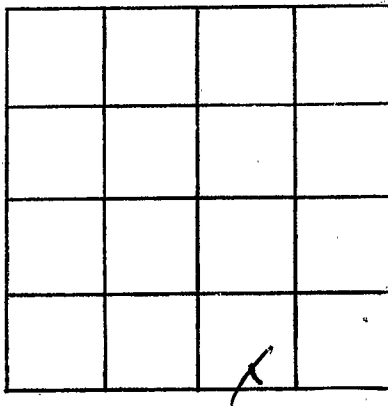

SECTION 31

Please indicate well location X.

ADDITIONAL INFORMATION

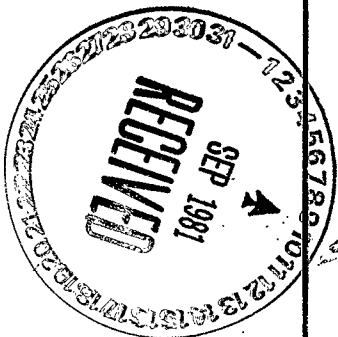

If more than one screen, show locations of each on sketch.