

MISSISSIPPI DEPARTMENT OF NATURAL RESOURCES

Bureau of Land and Water Resources

Southport Mall

P.O. Box 10631

CODED

Jackson, Mississippi 39209

WATER WELL DRILLERS LOG

Juniata
E 33
8/24/82

8/24 1982 date well completed Hester & Sons firm name Juniata county well located

LANDOWNER: Chas. J. Berry
Juniata, Miss
 (mailing address)

description of formations encountered	from	to
<u>Quartzite</u>	<u>6</u>	<u>31</u>
<u>Sol. mud</u>	<u>31</u>	<u>42</u>
<u>Topsoil</u>	<u>42</u>	<u>51</u>
<u>Coarse sand</u>	<u>51</u>	<u>97</u>
<u>Gravel</u>		

WELL LOCATION:
 sec 23 T 4 N R 10 E
3 1/2 miles (distance) N/E (direction) of Juniata (nearest town)

WELL PURPOSE: Drwa
 (home, irrigation, municipal, industrial)

CODED

WELL COMPLETION DATA:

(1) diameter (inches) 12"

(2) total depth (feet) 97 ft

(3) static water level (feet) 12 below top of ground.

(4) casing Steel (material) 57 ft (depth)

30 (size) if telescope see back.

(5) screen 10 (length) 59 (depth to top)

62" (size) aluminum (material)

(6) pump 60 (HP) 2000 (yield gpm)

Alcisel (type power)

(7) electric log no (yes or no)

no (organization running log)

(8) how well bottom plugged Steel plug

DEPT. OF NATURAL RESOURCES
 BUREAU OF LAND & WATER RESOURCES


SEP 30 1982

RECEIVED

DRILLERS REMARKS:
Good well

If well telescopes please sketch and show depths.

GROUND LEVEL

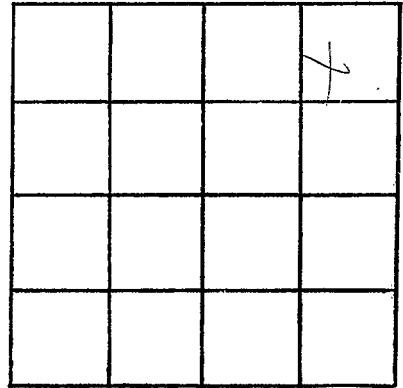

SECTION _____

Please indicate well location X.

ADDITIONAL INFORMATION

If more than one screen,
show locations of each on sketch.