

TUNICA
E 36

MISSISSIPPI
BOARD OF WATER COMMISSIONERS
416 North State Street
Jackson, Mississippi 39201

WATER WELL DRILLERS LOG

9/18/86 19 Fine Co. Inc. Tunica
date well completed firm name county well located

LANDOWNER:
Charles Berry
(mailing address)


WELL LOCATION:
sec. 3 T. 4 N. R. 10 E
5 miles W of Richmond
(distance) (direction) (nearest town)

WELL PURPOSE:
(home, irrigation, municipal, industrial)

WELL COMPLETION DATA:

- (1) diameter (inches) 16"
- (2) total depth (feet) 105'
- (3) static water level (feet) 16 ^{below} _{above} top of ground.
- (4) casing Steel, 55'
(material) (depth)
76
(size) if telescope see back.
- (5) screen 50, 55'
(length) (depth to top)
76, Steel
(size) (material)
- (6) pump 60, 2800
(HP) (yield gpm)
Acad
(type power)
- (7) electric log NA
(yes or no)
(organization running log)
- (8) how well bottom plugged welded

description of formations encountered	from	to
<u>top clay</u>	<u>0</u>	<u>14</u>
<u>Fine sand</u>	<u>14</u>	<u>36</u>
<u>Med sand</u>	<u>36</u>	<u>44</u>
<u>Coarse sand</u>	<u>44</u>	<u>72</u>
<u>sand & gra</u>	<u>72</u>	<u>105</u>
<u>clay</u>	<u>105</u>	

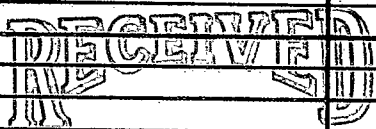


SEP 23 1986

Department of Natural Resources
Bureau of Land & Water Resources

DRILLERS REMARKS:

If well telescopes please sketch and show depths.

GROUND LEVEL

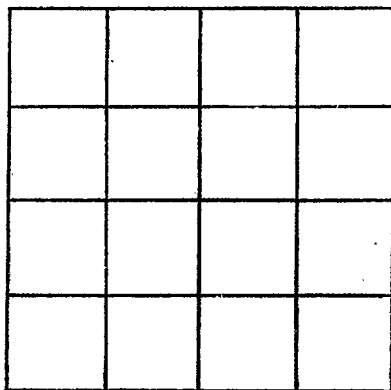

SECTION _____

Please indicate well location X.

ADDITIONAL INFORMATION

If more than one screen, show locations of each on sketch.