

TUNICA
E 37

MISSISSIPPI
BOARD OF WATER COMMISSIONERS
416 North State Street
Jackson, Mississippi 39201

CODED

WATER WELL DRILLERS LOG

9/20 1986 Five O' Jones Tunica
date well completed firm name county well located

LANDOWNER:
Charles Berry
Tunica
(mailing address)


description of formations encountered	from	to
<u>Top clay</u>	<u>0</u>	<u>14</u>
<u>Fine sand</u>	<u>14</u>	<u>48</u>
<u>Med sand</u>	<u>40</u>	<u>48</u>
<u>Coarse sand</u>	<u>48</u>	<u>64</u>
<u>sand & gravel</u>	<u>64</u>	<u>100</u>
<u>clay</u>	<u>180</u>	

WELL LOCATION:
sec 3 T 4 N R 10 E
5 miles N of Richards
(distance) (direction) (nearest town)

WELL PURPOSE:
(home, irrigation, municipal, industrial)

CODED

- WELL COMPLETION DATA:
- (1) diameter (inches) 16
 - (2) total depth (feet) 100
 - (3) static water level (feet) 16 below top of ground.
 - (4) casing Steel, 50,
(material) (depth)
16 If telescope see back.
(size)
 - (5) screen 50, 50
(length) (depth to top)
16, Steel
(size) (material)
 - (6) pump 60 2500
(HP) (yield gpm)
Acad
(type power)
 - (7) electric log no
(yes or no)
 - (organization running log)
 - (8) how well bottom plugged reworked

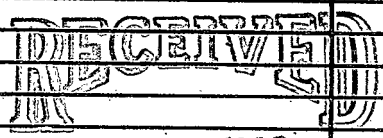

SEP 28 1986

DRILLERS REMARKS:

Department of Natural Resources
Bureau of Land & Water Resources

If well telescopes please sketch and show depths.

GROUND LEVEL

SECTION _____

Please indicate well location X.

ADDITIONAL INFORMATION

If more than one screen,
show locations of each on sketch.