

County: Tunica  
 Permit #: \_\_\_\_\_  
 Driller: Debra Dilling of Tunica  
 Date drilling completed: 7-1-09

**State Well Report  
Part I – Driller's Log**

Mississippi Department of Environmental Quality  
 Office of Land and Water Resources  
 P.O. Box 2307  
 Jackson, MS 39225  
 (601)961- 5210  
 (601)961- 5228 (fax)

**For Office Use Only:**  
 Aquirer: \_\_\_\_\_  
 Well #: E48  
 L. S. Elevation: \_\_\_\_\_  
 E-log #: \_\_\_\_\_

*State Law requires that this report be prepared by the license holder responsible for the work and filed with the Department at the above address within 30 days of completion of drilling of the well or borehole.*

Information on Well Owner <i>(Landowner if borehole is not for a water well)</i>	Well or Borehole Location
Owner Name: <u>Richie Bibb</u> Mailing Address: <u>P.O. Box 1075</u>  <u>Tunica</u> <u>Ms.</u> <u>38676</u> City State Zip Code Telephone No. <u>(662) 910-0233</u>	Latitude: <u>N 31° 42' 196"</u> Longitude: <u>90° 18' 26"</u> <u>45 53 17 03</u> Method of Lat/Long (circle one): Conventional Survey, USGS quad, <u>Hand-held GPS</u> Survey-grade GPS <u>10W</u> <u>NE 1/4 SW 1/4 Sec X5 Twn 95 Rng 4W</u> Distance Direction Nearest Town <u>5.5</u> Miles <u>NE</u> of <u>Tunica, Ms.</u>

**Well / Borehole Data**

Date drilling started: 7-1-09 Date drilling completed: 7-1-09 Hole depth: 91' Hole diameter: 28"

Location of the source of any surface water used for drilling: Hydrant  
 Method of dosing and volume of Chlorine used in drilling and development: \_\_\_\_\_

Logs run (circle all applicable): No log run Electric Gamma Ray Density Sonic Neutron Other: \_\_\_\_\_  
 Name of organization running log(s): \_\_\_\_\_

Purpose of borehole (check one): Water Well  Geotechnical/Geological Investigation \_\_\_ Ground Source Heat Pump \_\_\_  
 Seismic Survey \_\_\_ Other (describe) \_\_\_\_\_

*If drilling is not related to water well construction, skip the remainder of this block*

Purpose of Well (check one): Home \_\_\_ Industrial \_\_\_ Public Supply \_\_\_ Irrigation  Fish Culture \_\_\_ Other: \_\_\_\_\_

If a flowing well, method of flow regulation: Valve \_\_\_ Other (describe) \_\_\_\_\_

Static Water Level: 24 feet above or below (circle one) land surface Date measured: 7-10-09

Method of Measurement (circle one) steel tape electric tape air line other: \_\_\_\_\_

Well depth: 92 Well grouted to a depth of 10 feet Type of grout (circle one): Neat Cement Bentonite Mix

Casing length: 52 feet Casing diameter: 16 inches Type of casing: PVC

Screen length: 40 feet Screen diameter: 16 inches Type of screen: PVC

Screen slot size: .032 inches Setting depth: From 52 feet to 92 feet

Type of completion (circle all applicable): Gravel packed Underreamed Telescoped Open hole Natural Development  
 Other (describe): \_\_\_\_\_

Top of lap pipe or reduction in casing: \_\_\_\_\_ feet. *If telescoped or more than one screen, describe on next page*


Form: OLWR-SWR-1A (04/08)

**RECEIVED**  
**JUL 15 2009**  
**BY: OLWR**

The sketch below only required for water wells

Description of formations encountered must be provided for all wells and boreholes, unless specifically exempted by regulations


If well telescopes, show depths on sketch.

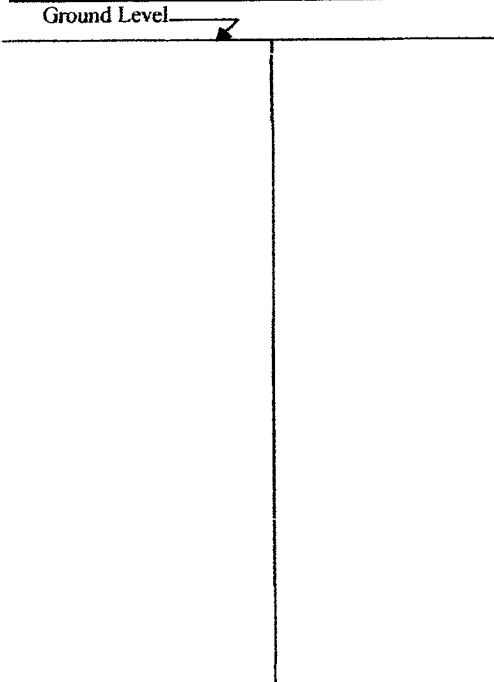

Description of Formations Encountered	From (depth)	To (depth)
loamy soil	Ground Level	19
Clay	20	32
Clay / fine sand	33	39
Coarse sand & gravel	40	92

If more than one screen, show location of each on sketch

Sketch the property layout and include the following: 1) the well location; 2) any permanent structures on the property that may aid in locating the well; 3) any roads, power lines, or other items that may aid in locating the property and the well; 4) a north arrow.

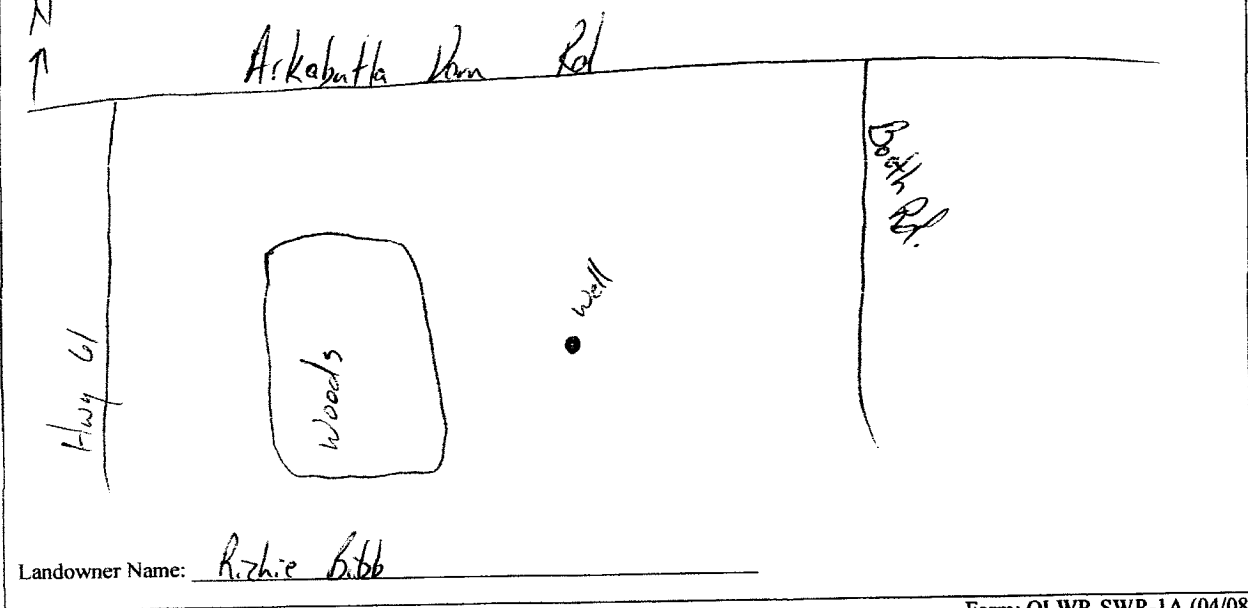

Form: OLWR-SWR-1A (04/08)

I certify that the well/borehole was drilled, constructed, and completed in accordance with all applicable requirements of the Mississippi Department of Environmental Quality and the Mississippi Department of Health regulations, if applicable, and state laws.

Alan Pyle # 01,74 7-12-09  
Print Name of Responsible Licensee and License No. Date

Alan Pyle  
Signature of Licensee

RECEIVED  
JUL 15 2009  
BY: OLWR

# STATE WELL REPORT

## Part 2

**Pump Installer's Completion Report**  
 Mississippi Department of Environmental Quality  
 Office of Land and Water Resources  
 P.O. Box 2309  
 Jackson, MS 39225  
 (601)961-5210  
 (601)961-5228 (fax)

County: Tunica  
 Permit #: \_\_\_\_\_  
 Driller: Delta Drilling of Tunica  
 Date completed: 7-10-09  
*Copy information from block on Part 1*

**For Office Use Only:**

Aquifer: \_\_\_\_\_  
 Well #: E48  
 Elevation: \_\_\_\_\_

*This part of the report must be completed by a licensed water well contractor or a licensed pump installer. A copy of Part 1 of the report must be attached and both parts filed with the Department at the above address within 30 days of well completion.*

Well Owner Information	Well Location
Owner Name: <u>R. Zach Bibb</u>	Latitude: <u>N 34° 42.145</u> Longitude: <u>W 90° 18.282</u>
Mailing Address: <u>P.O. Box 1075</u>	<u>AS 33</u> <u>17 02</u>
<u>Tunica</u> <u>MS.</u> <u>38676</u>	Method of Lat/Long (check one): Conventional Survey _____
City State Zip Code	USGS quad _____, Hand-held GPS <input checked="" type="checkbox"/> , Survey-grade GPS _____
Telephone No. <u>(662) 910-0233</u>	<u>NE 1/4 SW 1/4 Sec 25 T 45 R 16W 10W</u>
	Distance Direction Nearest Town
	<u>5.5 Miles NE of Tunica, MS.</u>

Pump Type Circle one	Power Type Circle one
Air Lift Jet Submersible	<u>Diesel Engine</u> Gasoline Engine Natural Gas
Bucket Piston <u>Turbine</u>	Electric Motor Hand Tractor PTO
Centrifugal Rotary Flowing Well	Windmill Other (specify): _____
Other (specify): _____	Horse Power Rating of Motor: <u>100</u>
Date Pump Installed: <u>7-10-09</u>	Setting Depth: <u>50</u> feet
Rated Pump Capacity: <u>1800</u> Gallons Per Minute	Number of Stages: <u>3</u>

Pump Test Data	Method of Measuring Water Level Circle one
Date Well Tested: _____	Air Line Electric Measuring Line <u>Steel Tape</u>
Static Water Level (A): _____ Feet Below Land Surface	Other (specify): _____
Pumping Water Level (B): _____ Feet Below Land Surface	For flowing well, measured shut in head: _____ feet
Drawdown [(B) - (A)]: _____ Feet Below Land Surface	Well yielded _____ GPM with a drawdown of _____ feet after _____ hours of pumping
Test Pumping Rate: _____ Gallons Per Minute	
Duration of Pump Test (minimum 4 hours): _____ hours	

I HEREBY CERTIFY that the above statements are true to the best of my knowledge.

Alan Pyle #0674 Alan Pyle  
 Print Name of Pump Installer and License No. (if applicable) Signature of Pump Installer

Form: OLWR-SWR-1B (04/08)

RECEIVED

JUL 15 2009

BY: OLWR