

TUNICA
E 2000
10-29-76

MISSISSIPPI
 BOARD OF WATER COMMISSIONERS
 416 North State Street
 Jackson, Mississippi 39201

WATER WELL DRILLERS LOG

10-29-76 19 ABEL & HOLLAND WELL SUPPLY TUNICA
 date well completed firm name county well located

LANDOWNER: <u>RICHARD HUSSEY</u>	description of formations encountered	from	to
<u>TUNICA, MISS. 38676</u> (mailing address)	<u>GUMBO</u>	<u>0</u>	<u>43</u>
	<u>MED. SAND</u>	<u>43</u>	<u>50</u>
	<u>COARSE SAND & GRAVEL</u>	<u>50</u>	<u>89</u>

WELL LOCATION:
 sec. 23 T. 4 S. R. 10 E. W.
1 1/2 miles NE of PRITCHARD
 (distance) (direction) (nearest town)

WELL PURPOSE: IRRIGATION
 (home, irrigation, municipal, industrial)


- WELL COMPLETION DATA:
- (1) diameter (inches) 16
 - (2) total depth (feet) 89
 - (3) static water level (feet) 20 below top of ground.
 - (4) casing STEEL, 49
 (material) (depth)
16 if telescope see back.
 (size)
 - (5) screen 40, 49
 (length) (depth to top)
16, STEEL
 (size) (material)
 - (6) pump NONE
 (HP) (yield gpm)
 (type power)
 - (7) electric log NO
 (yes or no)
 (organization running log)
 - (8) how well bottom plugged STEEL

DRILLERS REMARKS:

RECEIVED
 NOV 10 1976
 MISS. BD. OF WATER COMMISSIONERS

If well telescopes please sketch and show depths.

GROUND LEVEL

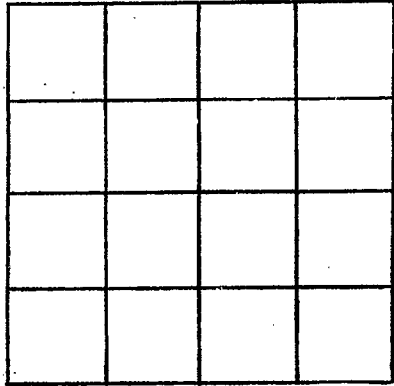

SECTION _____

Please indicate well location X.

ADDITIONAL INFORMATION

A series of horizontal lines for recording additional information, starting below the 'ADDITIONAL INFORMATION' header and extending to the bottom of the page.

If more than one screen, show locations of each on sketch.