

Junica
76
6-67

MISSISSIPPI
BOARD OF WATER COMMISSION
416 North State Street
Jackson, Mississippi 39201

CODED

WATER WELL DRILLERS LOG

June 20 19 67 Shelby Keyman Junica
date well completed firm name county well located

LANDOWNER: Lewis William Stewart
Junica Miss
R 7, D.
(mailing address)
WELL LOCATION:
sec. 15 T 5 S R 12 W
6 miles SW of Junica
(distance) (direction) (nearest town)
Village of Ruston


| description of formations encountered | from | to |
|---------------------------------------|------|----|
| Black Clay | 00 | 10 |
| Blue Sand | 10 | 50 |
| Grey Sand | 50 | 93 |

WELL PURPOSE: Home
(home, irrigation, municipal, industrial)

WELL COMPLETION DATA:
(1) diameter (inches) 2 in
(2) total depth (feet) 73
(3) static water level (feet) 20 below top of ground
(4) casing Galvanized 63 (material) (depth)

CODED


_____ if telescope see back.
(5) screen 6 ft 90 in (length) (depth to top)
1 1/4 (size) _____ (material)
(6) pump 1/2 jet 14 (HP) (yield gpm)
Electric (type power)
(7) electric log no (yes or no)
no (organization running log)
(8) how well bottom plugged _____

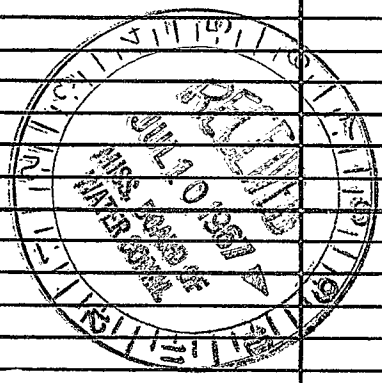

DRILLERS REMARKS:

If well telescopes please sketch and show depths.

GROUND LEVEL

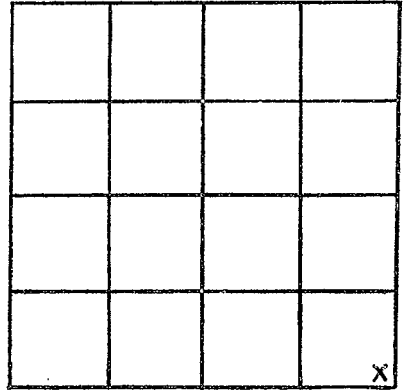

WELL

SECTION 15

Please indicate well location X.

ADDITIONAL INFORMATION

SE 1/4 SE 1/4 SE 1/4 Sec 15

If more than one screen, show locations of each on sketch.