

Junica
77
10-67

MISSISSIPPI
 BOARD OF WATER COMMISSIONERS
 416 North State Street
 Jackson, Mississippi 39201

CODED

WATER WELL DRILLERS LOG

Oct 31 1967 Shelby Keyman Junica
 date well completed firm name county well located


LANDOWNER: <u>S.W. Sealrook</u>	description of formations encountered	from	to
<u>R. F. D.</u> <u>Junica Miss</u> (mailing address)	<u>Black Sandy soil</u>	<u>0</u>	<u>10</u>
WELL LOCATION: sec. <u>21</u> T. <u>5</u> N R. <u>12</u> E <u>6</u> miles <u>SW</u> of <u>Junica</u> (distance) (direction) (nearest town)	<u>Grey Sand</u>	<u>60</u>	<u>75</u>
	<u>Clear Grey Sand</u>	<u>75</u>	<u>90</u>

WELL PURPOSE: Home
 (home, irrigation, municipal, industrial)

WELL COMPLETION DATA:

- (1) diameter (inches) 2
- (2) total depth (feet) 90
- (3) static water level (feet) 30 below top of ground.
- (4) casing _____ (material), _____ (depth), _____ (size) if telescope see back.
- (5) screen 6ft (length), _____ (depth to top), 2 in. (size), _____ (material)
- (6) pump 1/2 (HP), 3 (yield gpm)
Electric (type power)
- (7) electric log no (yes or no)
no (organization running log)
- (8) how well bottom plugged Screwed on to casing

CODED

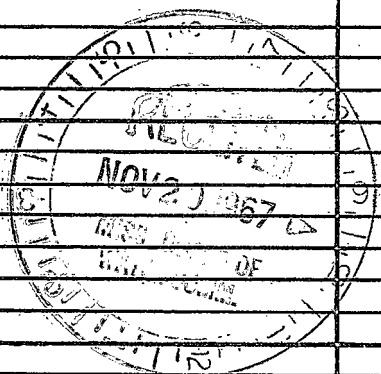


DRILLERS REMARKS:

If well telescopes please sketch and show depths.

GROUND LEVEL

Well

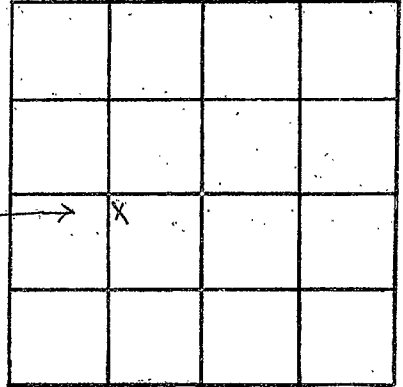

SECTION 21

Please indicate well location X.

ADDITIONAL INFORMATION

If more than one screen, show locations of each on sketch.