

TUNICA MISSISSIPPI BOARD OF WATER COMMISSIONERS

F 4 8
5-28-58

WATER WELL **CODED**

10/8/65
2500

Date: May 28, 1958, Driller: Layne-Central Company County Tunica

(Name)

1092, 94-97

- (1) Owner of Land: Clyde J. Perry
 Perioaks Farm (Name)
 Tunica, Mississippi
 (Address) 7, 18 5 11
36 3 12
- (2) Location: 1/4, 1/4, Sec. 15 R 12
5 miles southwest of Tunica
 (distance) (direction) (Nearest Town)
- (3) Topography: flat
 (Hilly) (Flat) (Level)
- (4) Purpose of Well: irrigation
 (Domestic Irrigation
 Municipal, Industrial, Other)

Description & Color of Materials Sand, Clay, Red Clay, Shell, etc.	Thick- ness Feet	Depth Feet
Top sandy soil	7	7
Clay	15	22
Fine blue sand	26	48
Medium sand	7	55
Coarse sand	17	72
Sand & gravel	20	92
Sand & gravel	20	112

Information upon completion of well:

- (1) Diameter 12 inches.
- (2) Total Depth 112 feet.
- (3) Water Level 15' 3" feet below top of ground.
- (4) Cased to 62', Size 12"
- (5) Screen: Size 12", Length 50'
- (6) Were any formations sealed against pollution?
no yes, no no.

If YES depth of formation _____


Why _____

Drillers Remarks:

1140 GPM.

Electric power.

CODED

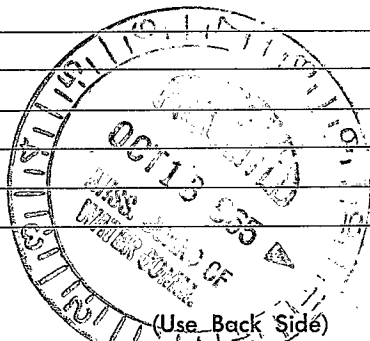

Well No.

