

CODED

MISSISSIPPI BOARD OF WATER COMMISSIONERS  
416 North State Street  
Jackson, Mississippi 39201

CODED

WATER WELL DRILLERS LOG  
DYER WELL & IRRIGATION SERVICE

THINICA

Thinica  
722  
8-10-69

8-10 1969  
date well completed

firm name

county well located

LANDOWNER:

STERLING SERRANO

description of formations encountered

from

to

Thinica, Miss.  
(mailing address)

CLAY 0 14  
SAND 14 26  
COARSE SAND & GRAVEL 26 90  
COARSE SAND & ROCK 90 112

WELL LOCATION:

sec. 22 T 5 S R 22 W  
7/8 miles So of Austin  
(distance) (direction) (nearest town)

WELL PURPOSE:

FISH  
(home, irrigation, municipal, industrial)

WELL COMPLETION DATA:

- (1) diameter (inches) 12"
- (2) total depth (feet) 110'
- (3) static water level (feet) 4' below top of ground.
- (4) casing BUR IR 70'  
(material) (depth)

CODED

(size) If telescope see back.

- (5) screen 40' 70'  
(length) (depth to top)

12" BUR IR  
(size) (material)

- (6) pump 35 1800  
(HP) (yield gpm)

Browse  
(type power)

- (7) electric log No  
(yes or no)

(organization running log)

- (8) how well bottom plugged Part


OCT 6 - 1969

MISS. BD. OF WATER COMM.

DRILLERS REMARKS:

If well telescopes please sketch and show depths.

GROUND LEVEL

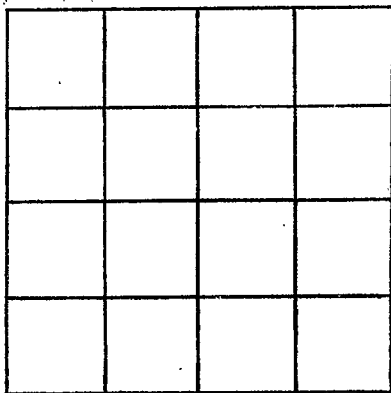

SECTION 22

Please indicate well location X.

ADDITIONAL INFORMATION

If more than one screen, show locations of each on sketch.