

CODED

CODED

Junica  
723  
9-30-69

MISSISSIPPI  
BOARD OF WATER COMMISSIONERS  
416 North State Street  
Jackson, Mississippi 39201

WATER WELL DRILLERS LOG  
DYER WELL & IRRIGATION SERVICE

Junica  
county well located

9-30-69 19  
date well completed

firm name

LANDOWNER: Hesterling Heathcock  
Junica  
Miss.  
(mailing address)

description of formations encountered	from	to
<u>Clay</u>	<u>0</u>	<u>13</u>
<u>Fine Sand</u>	<u>13</u>	<u>73</u>
<u>Coarse Sand</u>	<u>73</u>	<u>33</u>
<input checked="" type="checkbox"/>	<u>33</u>	<u>43</u>
<input checked="" type="checkbox"/>	<u>43</u>	<u>53</u>
<input checked="" type="checkbox"/>	<u>53</u>	<u>63</u>
<input checked="" type="checkbox"/>	<u>63</u>	<u>73</u>
<input checked="" type="checkbox"/>	<u>73</u>	<u>83</u>
<u>Coarse Sand</u>	<u>83</u>	<u>93</u>
<input checked="" type="checkbox"/>	<u>93</u>	<u>103</u>
<input checked="" type="checkbox"/>	<u>103</u>	<u>106</u>

WELL LOCATION:  
sec. 22 T 5 S R. 12 E  
S W  
1 miles So of Anduin  
(distance) (direction) (nearest town)

WELL PURPOSE: FISB  
(home, irrigation, municipal, industrial)

WELL COMPLETION DATA:

- (1) diameter (inches) 16"
- (2) total depth (feet) 105'
- (3) static water level (feet) 4 below above top of ground.
- (4) casing Bur. Ir. 65'  
(material) (depth)  
(size) If telescope see back.
- (5) screen 40 65'  
(length) (depth to top)  
16" Bur. Ir.  
(size) (material)
- (6) pump 60 3,000  
(HP) (yield gpm)  
DIESEL  
(type power)
- (7) electric log no  
(yes or no)

CODED

(organization running log)

(8) how well bottom plugged Partly


DRILLERS REMARKS:

OCT 6 - 1969

MISS. BD. OF  
WATER COMM.

If well telescopes please sketch and show depths.

GROUND LEVEL

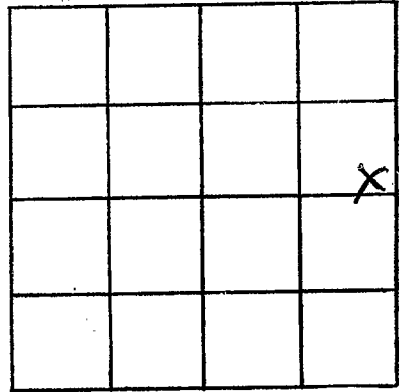

SECTION 22

Please indicate well location X.

ADDITIONAL INFORMATION

If more than one screen, show locations of each on sketch.