

12586
CODED

9/11/69
CODED
C2917

TUNICA
F-24
6-10-69

MISSISSIPPI
BOARD OF WATER COMMISSIONERS
416 North State Street
Jackson, Mississippi 39201
WATER WELL DRILLERS LOG

June 10, 1969 Layne-Central Company Tunica
date well completed firm name county well located

LANDOWNER: Clyde J. Perry
Tunica, Mississippi
(mailing address)

description of formations encountered	from	to
Clay	0	18
Clay balls	18	30
Coarse sand	30	45
Coarse sand & gravel	45	102

WELL LOCATION:
sec. 7 T 5 N R 12 E
S W
4 miles SW of Tunica
(distance) (direction) (nearest town)

WELL PURPOSE: irrigation
(home, irrigation, municipal, industrial)

- WELL COMPLETION DATA:
- (1) diameter (inches) 16
 - (2) total depth (feet) 102
 - (3) static water level (feet) 9'1" below top of ground.
 - (4) casing steel, 62' (material), (depth), 16" (size) if telescope see back.
 - (5) screen 40' (length), 102' (depth to top), 16" (size), Armco (material)
 - (6) pump 30 (HP), 1800 (yield gpm), electric (type power)
 - (7) electric log no (yes or no)
 - (organization running log)
 - (8) how well bottom plugged plate

CODED


SEP 19 1969

MISSISSIPPI BOARD OF WATER COMMISSIONERS

DRILLERS REMARKS:

If well telescopes please sketch and show depths.

GROUND LEVEL

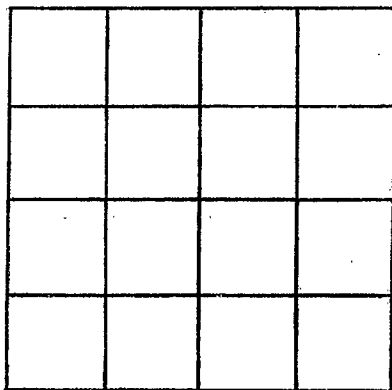

SECTION _____

Please indicate well location X.

ADDITIONAL INFORMATION

If more than one screen,
show locations of each on sketch.