

MISSISSIPPI
BOARD OF WATER COMMISSIONERS
416 North State Street
Jackson, Mississippi 39201

CODED

WATER WELL DRILLERS LOG

TUNICA
OF 28
9-22-70

9-22-70 date well completed
Wester Drilling Co firm name
Tunica county well located

LANDOWNER: Stirling Sea Brook
Tunica Miss

description of formations encountered	from	to
Clay	0	20
fine sand	20	60
coarse sand & gravel	60	108

(mailing address)

WELL LOCATION:
sec. 26 T 50 N R. 12 E
1/2 miles SE of Austin
(distance) (direction) (nearest town)

WELL PURPOSE:
(home, irrigation, municipal, industrial)

WELL COMPLETION DATA:

- (1) diameter (inches) 16"
- (2) total depth (feet) 108
- (3) static water level (feet) 12 ^{below} top of ground.
- (4) casing steel, 68 ft.
(material) (depth)
16 if telescope see back.
(size)
- (5) screen 40 ft., 68 ft.
(length) (depth to top)
16", MOSS
(size) (material)
- (6) pump 60 3000
(HP) (yield gpm)
DIESEL
(type power)
- (7) electric log _____
(yes or no)

(organization running log)
- (8) how well bottom plugged _____

CODED


OCT 8 1970

DRILLERS REMARKS:

MISS. BD. OF
WATER COMM.

If well telescopes please sketch and show depths.

GROUND LEVEL

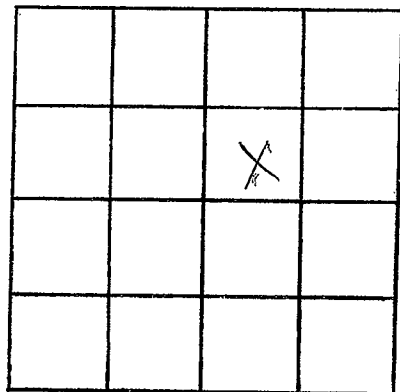

SECTION _____

Please indicate well location X.

ADDITIONAL INFORMATION

If more than one screen,
show locations of each on sketch.