

MISSISSIPPI DEPARTMENT OF NATURAL RESOURCES

Bureau of Land and Water Resources

COUNTY WELL LOCATED <i>Jackson</i>	
WELL NUMBER 733	CODED
DATE WELL COMPLETED 7-88	

PERMIT NUMBER
NAME OF DRILLING FIRM <i>Howell Drilling & Construction Rt 2 Box 208 Clarksdale, MS</i>

CODED

P.O. Box 10631
Jackson, Mississippi 39209
WATER WELL DRILLERS LOG

NAME & MAILING ADDRESS OF LANDOWNER <i>John White Junica, MS</i>			
WELL LOCATION:	SEC <i>28</i>	TOWNSHIP <i>5 S</i>	RANGE <i>12 W</i>
DISTANCE <i>4</i> Miles	DIRECTION <i>SW</i>	NEAREST TOWN <i>Evansville</i>	
OTHER LANDMARK			
WELL PURPOSE: Home Irrigation, Municipal, Industrial, Fish Pond, etc. <input checked="" type="checkbox"/> Home Irrigation			

PUMP DATA		
PUMP TYPE (Circle One): Submersible, <input checked="" type="checkbox"/> Turbine, Jet, Flowing Well, Other (Describe) _____		
POWER TYPE (Circle One): Electric, Tractor, <input checked="" type="checkbox"/> Diesel, Gasoline, Butane, Other (Describe) _____		
Pump Capacity (GPM) <i>1400</i>	No. of Stages <i>3</i>	Setting Depth <i>50</i> FT.
PUMP TEST Well yielded <i>1400</i> GPM with a drawdown of _____ ft. after _____ hours of pumping		

WELL DATA		
Well Depth <i>100'</i>	Casing Diameter (In.) <i>12"</i>	Casing Length (Ft.) <i>60'</i>
Type of Casing <i>Steel</i>	Hole Depth <i>100'</i>	Depth to Static Water Level <i>15'</i>
TYPE OF COMPLETION: (Circle One or More): <input checked="" type="checkbox"/> Gravel Packed, <input type="checkbox"/> Underreamed, <input type="checkbox"/> Telescoped, <input type="checkbox"/> Natural Development, <input type="checkbox"/> Open Hole, <input type="checkbox"/> Other (Describe) _____		
Top of Lap Pipe or Reduction in Casing FEET <input type="checkbox"/> IF TELESCOPED OR MORE THAN ONE SCREEN: USE BACK PAGE		

LOG DATA	
TYPE OF LOG RUN (Circle One): No Log Run, Electric, Gamma Ray, Density, Sonic, Neutron, Other (Describe) _____	
Name of Organization Running Log	

SCREEN DATA		
Diameter - Inches <i>12"</i>	Length - Feet <i>40'</i>	Slot Size - Inches <i>6030</i>
Screen Type <i>Steel</i>	Depth to Bottom - Feet <i>100'</i>	

GEOLOGIC DATA (Office Use Only)			
Surface Elev.	Geologic Unit	Unit Thickness	Depth to Top
Subs. SWL	Date	Analysis	Aquifer Test
Driller's Remarks			

DESCRIPTION OF FORMATIONS ENCOUNTERED	FROM	TO	FORMATIONS (Continued) FROM TO
<i>Clay</i>	<i>0</i>	<i>20</i>	
<i>fine clay</i>	<i>20</i>	<i>40</i>	
<i>clay sand & gravel</i>	<i>40</i>	<i>100</i>	

RECEIVED


SEP 22 1988

Department of Natural Resources
Bureau of Land & Water Resources

IF MORE SPACE IS NEEDED, USE BACK

If well telescopes please
sketch and show depths.

GROUND LEVEL

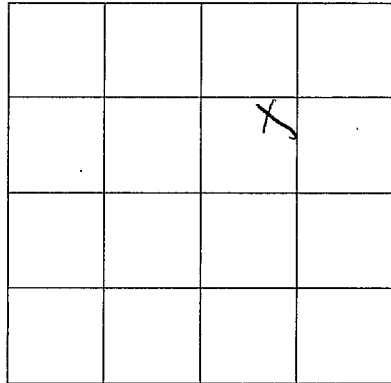

SECTION 28

Please indicate well location X.

ADDITIONAL INFORMATION

If more than one screen,
show location of each on sketch.