

TUNICA
G-10
6-28-71

MISSISSIPPI
BOARD OF WATER COMMISSIONERS
416 North State Street
Jackson, Mississippi 39201

CODED

WATER WELL DRILLERS LOG

6/28/71 1971 J.H. ABEL & SON Inc TUNICA
date well completed firm name county well located

LANDOWNER: STERLING OWENS
TUNICA MISSISSIPPI
(mailing address)

description of formations encountered	from	to
Clay	0	7'
MUD	7	15'
FINE SAND	15	30'
Clay layer	30	33'
MED SAND	33	55'
COURSE SAND	55	69'

WELL LOCATION:
sec 26 T 5 S R 11 W
Approx 5 miles SE of TUNICA
(distance) (direction) (nearest town)

WELL PURPOSE: FARM
(home, irrigation, municipal, industrial)

- WELL COMPLETION DATA:
- (1) diameter (inches) 2" ID
 - (2) total depth (feet) 69'
 - (3) static water level (feet) 16' below top of ground.
 - (4) casing CALUMET, 63' (material) (depth)
2" if telescope see back. (size)
 - (5) screen 6", 63' (length) (depth to top)
 - 2", BRASS (size) (material)
 - (6) pump 1, 35' (HP) (yield gpm)
 - ELECTRIC (type power)
 - (7) electric log NO (yes or no)
 - (organization running log)
 - (8) how well bottom plugged STERLING OWENS

CODED


JUL 1 1971

MISS-22-05
MISSISSIPPI BOARD OF WATER COMMISSIONERS

DRILLERS REMARKS:
WELL USED TO FILL PREVIOUS TANK & WASH FARM EQUIPMENT

If well telescopes please sketch and show depths.

GROUND LEVEL

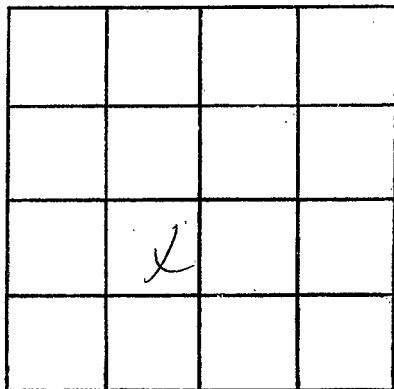

SECTION 26

Please indicate well location X.

ADDITIONAL INFORMATION

If more than one screen, show locations of each on sketch.