

TUNICA Co.
G12
Elog #9

MISSISSIPPI
BOARD OF WATER COMMISSIONERS
416 North State Street
Jackson, Mississippi 39201
WATER WELL DRILLERS LOG

CODED

CODED

Dec. 31 1972 Carlross Well Supply Co. Tunica
date well completed firm name county well located


LANDOWNER:	description of formations encountered	from	to
White Oaks Subdivision			
Tunica, Mississippi	Sand	2	95
(mailing address)	Sand & Gravel	95	156
WELL LOCATION:	Sandy Clay	156	547
sec. 15 T. 5 N. R. 11 W.	White Clay	547	638
6 miles South of Tunica	Brown Clay	638	941
(distance) (direction) (nearest town)	Sand & Lignite	941	1215
WELL PURPOSE: municipal	Brown Shale	1215	1308
(home, irrigation, municipal, industrial)	Blue Shale	1308	1649
WELL COMPLETION DATA:	Sand	1649	1799
(1) diameter (inches) 12"	Clay	1799	1836
(2) total depth (feet) 1737			
(3) static water level (feet) 1' below top of ground.			
(4) casing Steel 1667'			
(material) (depth)			
12" (size) if telescope see back.			
(5) screen 60 1677'			
(length) (depth to top)			
6" Stainless Steel			
(size) (material)			
(6) pump 20 300			
(HP) (yield gpm)			
electric			
(type power)			
(7) electric log Yes			
(yes or no)			
Mississippi State Geo.			
(organization running log)			
(8) how well bottom plugged valve B.P.			
DRILLERS REMARKS:			

CODED

CODED

If well telescopes please sketch and show depths.

GROUND LEVEL

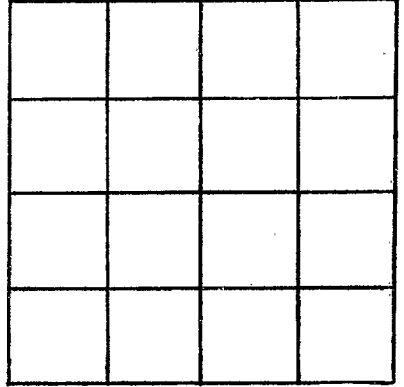

SECTION _____

Please indicate well location X.

ADDITIONAL INFORMATION

If more than one screen,
show locations of each on sketch.