

Tunica
 G 13
 7-23-73

MISSISSIPPI
 BOARD OF WATER COMMISSIONERS
 416 North State Street
 Jackson, Mississippi 39201

CODED

WATER WELL DRILLERS LOG

JUNE 11 1973 WATSON Co. TUNICA
 date well completed firm name county well located

LANDOWNER: COMMERCE

description of formations encountered

from to

FARMS

GUMBO

0' 17'

ROBINSONVILLE, MISS.
 (mailing address)

COARSE SAND

SOME GRAVEL 17 55

WELL LOCATION:

sec. 3 T 5 N R 11 E
2 miles SE of TUNICA
 (distance) (direction) (nearest town)

WELL PURPOSE: AGRICULTURE
 (home, irrigation, municipal, industrial)

WELL COMPLETION DATA:

- (1) diameter (inches) 2"
- (2) total depth (feet) 55'
- (3) static water level (feet) 8'8" ^{below}/_{above} top of ground
- (4) casing 24' 2" PVC
 (material) (depth)

— if telescope see back.
 (size)

- (5) screen 10' ; 45'
 (length) (depth to top)
- 2" PVC
 (size) (material)

- (6) pump 3 50 G.P.M.
 (HP) (yield gpm)

GASOLINE
 (type power)

- (7) electric log No
 (yes or no)

—
 (organization running log)


- (8) how well bottom plugged P.V.C.
CAP.

DRILLERS REMARKS:

JUN 11 1973

If well telescopes please sketch and show depths.

GROUND LEVEL

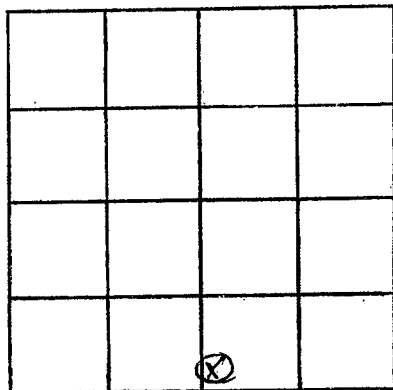

SECTION 3

Please indicate well location X.

ADDITIONAL INFORMATION

If more than one screen, show locations of each on sketch.