

TUNICA  
 G 19  
 4-27-74

MISSISSIPPI  
 BOARD OF WATER COMMISSIONERS  
 416 North State Street  
 Jackson, Mississippi 39201

CODED

WATER WELL DRILLERS LOG

4-27 1974 Hester Drilling Co Tunica  
 date well completed firm name county well located

LANDOWNER: W. H. Houston  
Tunica Miss  
 (mailing address)

description of formations encountered	from	to
clay	0	38
fine sand	38	60
coarse sand & gravel	60	110

WELL LOCATION:  
 sec. 2 T S R 11 E  
6 miles SE of Tunica  
 (distance) (direction) (nearest town)

WELL PURPOSE:  
 (home, irrigation, municipal, industrial)

CODED

WELL COMPLETION DATA:

- (1) diameter (inches) 16
- (2) total depth (feet) 110
- (3) static water level (feet) 12 below/above top of ground
- (4) casing steel, 70 (material), (depth)  
16" (size) if telescope see back.
- (5) screen 40', 70 (length), (depth to top)  
16", steel (size), (material)
- (6) pump 60 (HP), 3000 (yield gpm)  
Diesel (type power)
- (7) electric log no (yes or no)

(organization running log)


(8) how well bottom plugged plate

DRILLERS REMARKS:

RECORDED  
 MAY 29 1974

If well telescopes please sketch and show depths.

GROUND LEVEL

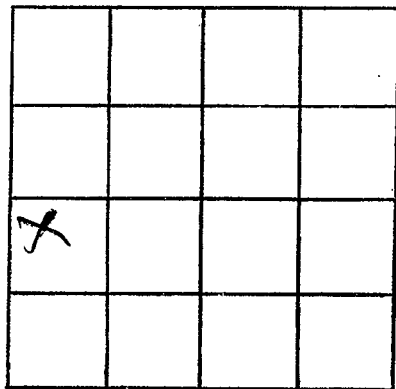

SECTION \_\_\_\_\_

Please indicate well location X.

ADDITIONAL INFORMATION

If more than one screen,  
show locations of each on sketch.