

TUNICA
 G 20
 4-23-74

MISSISSIPPI
 BOARD OF WATER COMMISSIONERS
 416 North State Street
 Jackson, Mississippi 39201

CODED

WATER WELL DRILLERS LOG

4-23-1974 Hester Drilling Co. Tunica
 date well completed firm name county well located

LANDOWNER: W.R. Houston
Tunica Miss
 (mailing address)

description of formations encountered	from	to
clay	0	42
fine sand	42	55
coarse sand & gravel	55	103

WELL LOCATION:
 sec. 11 T. 5 N. R. 11 E.
5 miles SE of Tunica
 (distance) (direction) (nearest town)

WELL PURPOSE:
 (home, irrigation, municipal, industrial)

WELL COMPLETION DATA:

(1) diameter (inches) 12

(2) total depth (feet) 103

(3) static water level (feet) 12" below top of ground.

(4) casing steel, 63 (material) (depth)
12" if telescope see back. (size)

(5) screen 40', 63 (length) (depth to top)
12", steel (size) (material)

(6) pump 40, 2000 (HP) (yield gpm)
Behrman (type power)

(7) electric log no (yes or no)

(organization running log)

(8) how well bottom plugged date


CODED

REGISTERED
 MAY 23 1974

DRILLERS REMARKS:

If well telescopes please sketch and show depths.

GROUND LEVEL

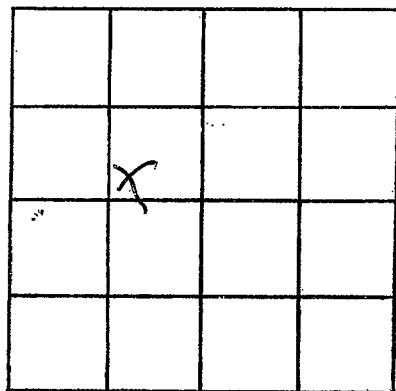

SECTION _____

Please indicate well location X.

ADDITIONAL INFORMATION

If more than one screen,
show locations of each on sketch.