

Tunica
G 22
8-8-69

MISSISSIPPI
 BOARD OF WATER COMMISSIONERS
 416 North State Street
 Jackson, Mississippi 39201

CODED
 CODED

WATER WELL DRILLERS LOG

DYER WELL & IRRIGATION SERVICE

CODED

8-8-69
 date well completed

firm name

Tunica
 county well located

LANDOWNER: Paul Battle

description of formations encountered

from to

TUNICA

description of formations encountered	from	to
<u>Clay</u>	<u>0</u>	<u>13</u>
<u>Fine Sand</u>	<u>13</u>	<u>23</u>
<u>Coarse Sand</u>	<u>23</u>	<u>33</u>
<u>✓ + gravel</u>	<u>33</u>	<u>43</u>
<u>✓</u>	<u>43</u>	<u>53</u>
<u>✓</u>	<u>53</u>	<u>63</u>
<u>✓</u>	<u>63</u>	<u>73</u>
<u>✓</u>	<u>73</u>	<u>83</u>
<u>✓</u>	<u>83</u>	<u>93</u>
<u>✓</u>	<u>93</u>	<u>103</u>

MISS.
 (mailing address)

WELL LOCATION:

sec 25 T 5 S R 11 W
6 miles S.E. of Tunica
 (distance) (direction) (nearest town)

WELL PURPOSE: FISH
 (home, irrigation, municipal, industrial)

WELL COMPLETION DATA:

- (1) diameter (inches) 12"
- (2) total depth (feet) 93'
- (3) static water level (feet) 15' below above top of ground.
- (4) casing BUR IR. 53'
 (material) (depth)
12" if telescope see back.
 (size)
- (5) screen 40' 53'
 (length) (depth to top)
12" BUR IR.
 (size) (material)
- (6) pump 35 1800
 (HP) (yield gpm)
BASINCO
 (type power)
- (7) electric log No
 (yes or no)

CODED

(organization running log)

(8) how well bottom plugged PLATE


UGT 6 - 1969

DRILLERS REMARKS:

MISS. BD. OF
 WATER COMM.

If well telescopes please sketch and show depths.

GROUND LEVEL

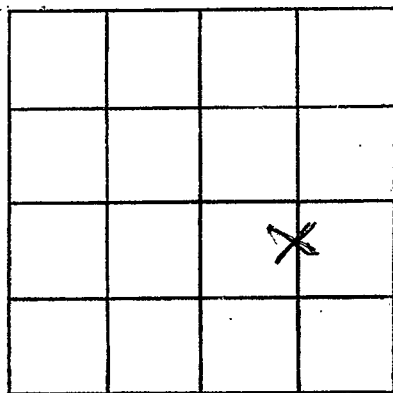

25

SECTION 25

Please indicate well location X.

ADDITIONAL INFORMATION

If more than one screen, show locations of each on sketch.