

TUNICA  
G 25  
9-15-74

MISSISSIPPI  
BOARD OF WATER COMMISSIONERS  
416 North State Street  
Jackson, Mississippi 39201

CODEL

WATER WELL DRILLERS LOG

9-15 1974 Arster Drilling Tunica  
date well completed firm name county well located

LANDOWNER: W H Houston  
Tunica Miss  
(mailing address)

description of formations encountered	from	to
	clay	0
<del>10</del> fine sand	10	45
coarse sand	45	103

WELL LOCATION:  
sec. 22 T S R 11 E  
4 miles East of Burnsville  
(distance) (direction) (nearest town)

WELL PURPOSE: irrigation  
(home, irrigation, municipal, industrial)


- WELL COMPLETION DATA:
- (1) diameter (inches) 12"
  - (2) total depth (feet) 103'
  - (3) static water level (feet) 10 below/above top of ground.
  - (4) casing 12" (material) 63' (depth)
  - 12" (size) If telescope see back.
  - (5) screen 40' (length) 63' (depth to top)
  - 12 (size) steel (material)
  - (6) pump 90 (HP) 1200 (yield gpm)
  - Diesel (type power)
  - (7) electric log no (yes or no)
  - (organization running log)
  - (8) how well bottom plugged Plastic

DRILLERS REMARKS:

REC'D  
OCT 29 1974  
MISS. BD. OF WATER COMMISSIONERS

If well telescopes please sketch and show depths.

GROUND LEVEL

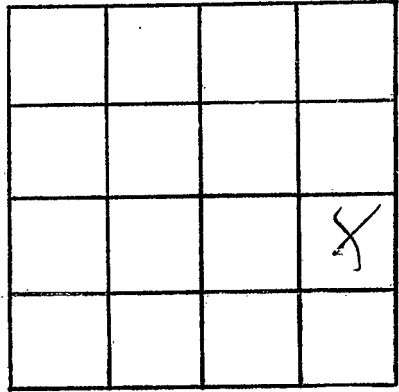

SECTION \_\_\_\_\_

Please indicate well location X.

ADDITIONAL INFORMATION

If more than one screen,  
show locations of each on sketch.