

TUNICA  
 B 28  
 9-7-78

MISSISSIPPI  
 BOARD OF WATER COMMISSIONERS  
 416 North State Street  
 Jackson, Mississippi 39201

CODED

WATER WELL DRILLERS LOG

9-7 1978 Nestor Drilling Tunica  
 date well completed firm name county well located

LANDOWNER: W.H. Huston  
 Huston Farms  
 Tunica, Miss.  
 (mailing address)

description of formations encountered

from	to
0	8
8	40
40	100

WELL LOCATION:  
 sec. 22 T. 5 N. R. 11 E  
 5 miles SW of Tunica  
 (distance) (direction) (nearest town)

WELL PURPOSE: TVR  
 (home, irrigation, municipal, industrial)

WELL COMPLETION DATA:

(1) diameter (inches) 7 1/2"

(2) total depth (feet) 700

(3) static water level (feet) 15 below top of ground.

(4) casing Steel 600 (material) (depth)  
 (size) If telescope see back.

(5) screen 40' 60' (length) (depth to top)  
 12" Steel (size) (material)


(6) pump 30 2000 (HP) (yield gpm)  
 P.V. (type power)

(7) electric log no (yes or no)

(organization running log)

(8) how well bottom plugged Steel plate

CODED

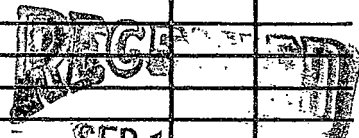


MISS. Bd. of WATER COMM

DRILLERS REMARKS:

If well telescopes please sketch and show depths.

GROUND LEVEL

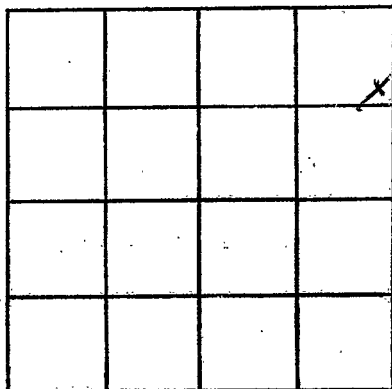

SECTION 22

Please indicate well location X.

ADDITIONAL INFORMATION

If more than one screen,  
show locations of each on sketch.