

CODED

MISSISSIPPI
BOARD OF WATER COMMISSIONERS
416 North State Street
Jackson, Mississippi 39201

WATER WELL DRILLERS LOG

TUNICA
G 29
11-22-73

11-22 1973 Hester Drilling Co Tunica
date well completed firm name county well located

LANDOWNER: H G Girdley

description of formations encountered

from to

Tunica, Miss -

Clay 0 10
fine sand 10 45
course sand & GRAVEL 45 103

(mailing address)

WELL LOCATION:

sec. 3 T 5 N R 11 E
2 miles E of Tunica
(distance) (direction) (nearest town)

WELL PURPOSE:
(home, irrigation, municipal, industrial)

WELL COMPLETION DATA:

- (1) diameter (inches) 16
- (2) total depth (feet) 103
- (3) static water level (feet) 17 below above top of ground.
- (4) casing steel, 63 (material) (depth)
16 (size) if telescope see back.
- (5) screen 40 ft, 63 (length) (depth to top)
16, steel (size) (material)
- (6) pump 80 3000 (HP) (yield gpm)
Diesel (type power)
- (7) electric log no (yes or no)
- (organization running log)
- (8) how well bottom plugged PLATE

CODED


DRILLERS REMARKS:

NOV 21 1973

MISSISSIPPI
BOARD OF WATER COMMISSIONERS

If well telescopes please sketch and show depths.

GROUND LEVEL

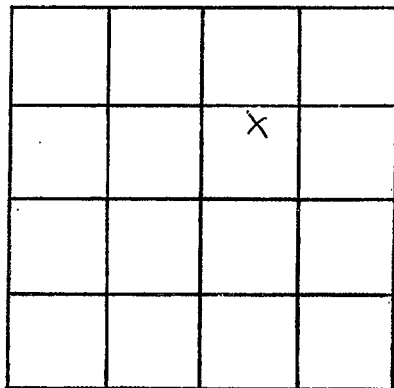

SECTION 3

Please indicate well location X.

ADDITIONAL INFORMATION

If more than one screen,
show locations of each on sketch.