

TUNICA
 G 30
 9-15-80

MISSISSIPPI
 BOARD OF WATER COMMISSIONERS
 416 North State Street
 Jackson, Mississippi 39201

CODED

WATER WELL DRILLERS LOG

9-15 date well completed
 1980 firm name
 Hester Drilling Tunica MS county well located

LANDOWNER: Paul Balthis
 Tunica MS
 (mailing address)

description of formations encountered	from	to
	clay	0'
fine sand	41'	55'
sand & gravel	55'	103'

WELL LOCATION:
 sec. 14 T 5 N R 11 E
 S W
 5 miles SE of Tunica
 (distance) (direction) (nearest town)

WELL PURPOSE: Irrigation
 (home, irrigation, municipal, industrial)


- WELL COMPLETION DATA:
- (1) diameter (inches) 16"
 - (2) total depth (feet) 103
 - (3) static water level (feet) 13' below top of ground
 - (4) casing steel 63' (material) (depth)
 16" (size) if telescope see back.
 - (5) screen 40' 63' (length) (depth to top)
 16" steel (size) (material)
 - (6) pump 60 3000 (HP) (yield gpm)
 Diesel (type power)
 - (7) electric log no (yes or no)
 (organization running log)
 - (8) how well bottom plugged steel plate

DEPT. OF NATURAL RESOURCES
 BUREAU OF LAND & WATER RESOURCES
 OCT - 7 1980
 RECEIVED

DRILLERS REMARKS:

If well telescopes please sketch and show depths.

GROUND LEVEL

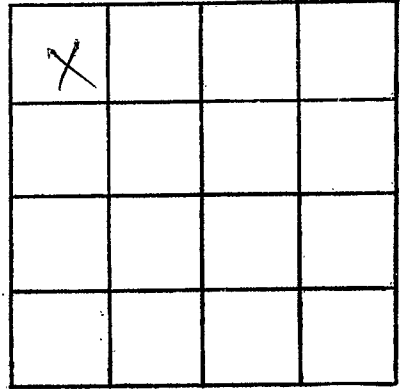

SECTION _____

Please indicate well location X.

ADDITIONAL INFORMATION

If more than one screen, show locations of each on sketch.