

TUNICA

G 31

9-2-80

9-2
date well completed

MISSISSIPPI
BOARD OF WATER COMMISSIONERS
416 North State Street
Jackson, Mississippi 39201

WATER WELL DRILLERS LOG

CODED

1980 Arstra Drilling Co Tunica
firm name county well located

LANDOWNER: J W McClinton

Tunica MS

(mailing address)

description of formations encountered

from to

clay	0'	15'
pink sand	15'	25'
D-sand + gravel	25'	110'

WELL LOCATION:

sec. 12 T. 5 N. R. 11 E.
X 3 1/2 miles SE of Tunica
(distance) (direction) (nearest town)

WELL PURPOSE: irrigation
(home, irrigation, municipal, industrial)

WELL COMPLETION DATA:

- (1) diameter (inches) 16"
- (2) total depth (feet) 110'
- (3) static water level (feet) 16' below top of ground.
- (4) casing Steel 70'
(material) (depth)
16" If telescope see back.
(size)
- (5) screen 40" 70'
(length) (depth to top)
16" Steel
(size) (material)
- (6) pump 100 3000
(HP) (yield gpm)
Diesel
(type power)
- (7) electric log no
(yes or no)

(organization running log)
- (8) how well bottom plugged steel plate

DEPT. OF NATURAL RESOURCES
BUREAU OF LAND & WATER RESOURCES


OCT - 7 1980

RECEIVED

DRILLERS REMARKS:

If well telescopes please sketch and show depths.

GROUND LEVEL

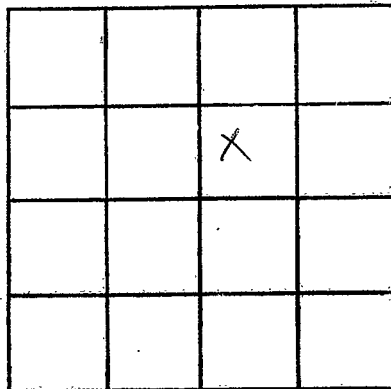

SECTION _____

Please indicate well location X.

ADDITIONAL INFORMATION

If more than one screen, show locations of each on sketch.