

Junica  
G 32  
8-3-81

MISSISSIPPI DEPARTMENT OF NATURAL RESOURCES

Bureau of Land and Water Resources

Southport Mall

P.O. Box 10631

Jackson, Mississippi 39209

WATER WELL DRILLERS LOG

8-3 1981 Hester Drilling Junica  
 date well completed firm name county well located

LANDOWNER: W. H. Howell

description of formations encountered

from to

Jarvis  
Junica, Miss  
 (mailing address)

<u>Clay</u>	<u>0</u>	<u>20</u>
<u>Sand</u>	<u>20</u>	<u>32</u>
<u>Thin sand</u>	<u>32</u>	<u>46</u>
<u>Coarse sand</u>	<u>46</u>	<u>90</u>
<u>+ gravel</u>		

WELL LOCATION: 513  
 2 sec 6 T 7 R 10  
0 1 miles East of Junica  
 (distance) (direction) (nearest town)

WELL PURPOSE: Dom  
 (home, irrigation, municipal, industrial)

WELL COMPLETION DATA:

- (1) diameter (inches) 8
- (2) total depth (feet) 90
- (3) static water level (feet) 12 below above top of ground.
- (4) casing Plastic 50  
 (material) (depth)
- 8 if telescope see back.  
 (size)
- (5) screen 40 50  
 (length) (depth to top)
- 8 Plastic  
 (size) (material)
- (6) pump 15 1100  
 (HP) (yield gpm)
- Elect  
 (type power)
- (7) electric log no  
 (yes or no)

no  
 (organization running log)

(8) how well bottom plugged Plastic  
Cap

DRILLERS REMARKS:


DEPT OF NATURAL RESOURCES  
 BUREAU OF LAND & WATER RESOURCES

SEP - 9 1981

RECEIVED

If well telescopes please sketch and show depths.


GROUND LEVEL

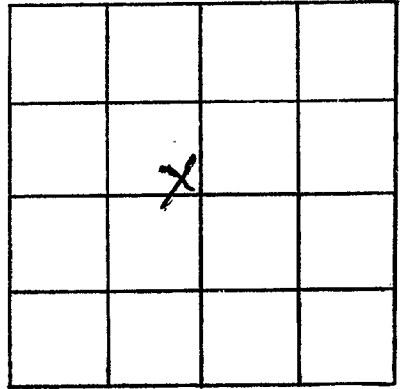

SECTION 6

Please indicate well location X.

ADDITIONAL INFORMATION

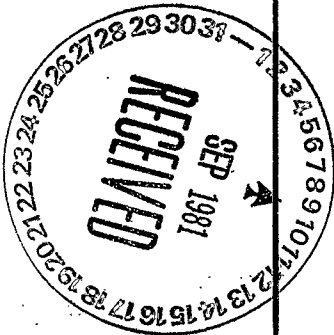

If more than one screen, show locations of each on sketch.