

MISSISSIPPI DEPARTMENT OF NATURAL RESOURCES

Bureau of Land and Water Resources

Southport Mall

P.O. Box 10631

Jackson, Mississippi 39209

WATER WELL DRILLERS LOG

CODED

TUNICA  
Q 36

7-10-84  
date well completed

Hester Drill  
firm name

Tunica  
county well located


LANDOWNER: <u>Hal Hamrick</u>	description of formations encountered	from	to
<u>Farms</u>			
<u>TUNICA, MISS</u> (mailing address)	<u>Clay Co FINE SAND</u>	<u>0</u>	<u>50</u> <u>80</u>
WELL LOCATION: sec. <u>1</u> T. <u>5</u> N. R. <u>11</u> E. <u>3</u> miles <u>E</u> of <u>TUNICA</u> (distance) (direction) (nearest town)	<u>COURSE SAND</u>	<u>80</u>	<u>128</u>
WELL PURPOSE: (home, irrigation, municipal, industrial)			
WELL COMPLETION DATA:			
(1) diameter (inches) <u>8</u>			
(2) total depth (feet) <u>128</u>			
(3) static water level (feet) <u>16</u> below top of ground.			
(4) casing <u>Plastic, 88</u> (material) (depth)			
_____ if telescope see back. (size)			
(5) screen <u>40</u> , <u>88</u> (length) (depth to top)			
<u>8</u> , <u>Plastic</u> (size) (material)			
(6) pump <u>15</u> <u>1100</u> (HP) (yield gpm)			
<u>Elect</u> (type power)			
(7) electric log <u>NO</u> (yes or no)			
_____ (organization running log)			
(8) how well bottom plugged <u>Plastic CAP</u>			
DRILLERS REMARKS:			

CODED

RECEIVED  
SEP 12 1984  
BUREAU OF LAND & WATER RESOURCES

If well telescopes please sketch and show depths.

GROUND LEVEL

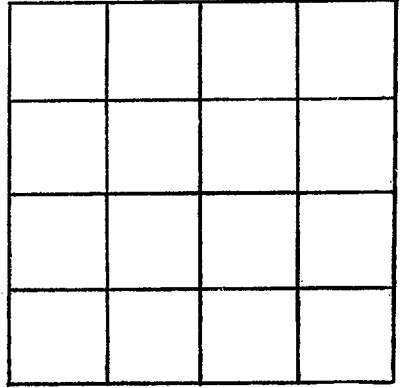

SECTION \_\_\_\_\_

Please indicate well location X.

ADDITIONAL INFORMATION

If more than one screen,  
show locations of each on sketch.