

MISSISSIPPI DEPARTMENT OF NATURAL RESOURCES

Bureau of Land and Water Resources

Southport Mall

P.O. Box 10631

Jackson, Mississippi 39209

WATER WELL DRILLERS LOG

CODED

TUNICA
G 37

8-9-84
date well completed

Hester DEN Tunica
firm name county well located

LANDOWNER: <u>Mickey Johnson</u>	Description of formations encountered	from	to
<u>Tunica, Miss</u> (mailing address)	<u>BUMBU FINE SAND</u>	<u>0</u>	<u>46</u> <u>55</u>
WELL LOCATION: sec <u>33</u> T <u>5</u> N R <u>11</u> E <u>15</u> miles <u>S/E</u> of <u>Tunica</u> (distance) (direction) (nearest town)	<u>COURSE SAND + GRAVEL</u>	<u>55</u>	<u>103</u>
WELL PURPOSE: (home, irrigation, municipal, industrial)			
WELL COMPLETION DATA:			
(1) diameter (inches) <u>16</u>			
(2) total depth (feet) <u>103</u>			
(3) static water level (feet) <u>18</u> below top of ground.			
(4) casing <u>Steel</u> <u>63</u> (material) (depth)			
_____ if telescope see back. (size)			
(5) screen <u>40</u> <u>63</u> (length) (depth to top)			
<u>16</u> <u>Steel</u> (size) (material)			
(6) pump <u>60</u> <u>2500</u> (HP) (yield gpm)			
<u>Power Unit</u> (type power)			
(7) electric log <u>NO</u> (yes or no)			
_____ (organization running log)			
(8) how well bottom plugged <u>Steel Case</u>			
DRILLERS REMARKS:			

CODED


DEPT. OF NATURAL RESOURCES
BUREAU OF LAND & WATER RESOURCES

SEP 12 1984

RECEIVED

If well telescopes please sketch and show depths.

GROUND LEVEL

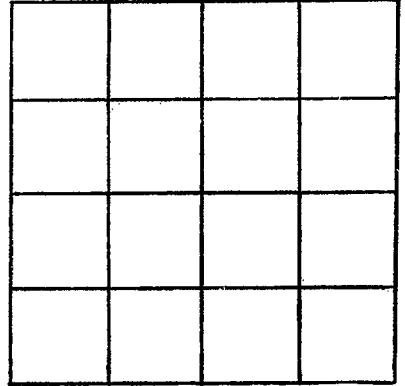

SECTION _____

Please indicate well location X.

ADDITIONAL INFORMATION

If more than one screen,
show locations of each on sketch.