

MISSISSIPPI DEPARTMENT OF NATURAL RESOURCES

Bureau of Land and Water Resources

Southport Mall

P.O. Box 10631

Jackson, Mississippi 39209

WATER WELL DRILLERS LOG

CODED

TUNICA
638

6-27-84 19 Harper Driv TUNICA
date well completed firm name county well located

LANDOWNER: Scott
Arnold-Farms
TUNICA, MISS
(mailing address)

description of formations encountered	from	to
<u>Cum Bo</u>	<u>0</u>	<u>49</u>
<u>FINE SAND</u>	<u>27</u>	<u>57</u>
<u>Course 11</u>	<u>54</u>	<u>100</u>

WELL LOCATION:
sec. 15 T 5 N R 11 E
10 miles S of TUNICA
(distance) (direction) (nearest town)

WELL PURPOSE:
(home, irrigation, municipal, industrial)

WELL COMPLETION DATA:

(1) diameter (inches) 12

(2) total depth (feet) 100

(3) static water level (feet) 13 below above top of ground.

(4) casing Steel, 60,
(material) (depth)

_____ If telescope see back.
(size)

(5) screen 40, 60
(length) (depth to top)

12, Steel
(size) (material)

(6) pump 60 2000
(HP) (yield gpm)

Power Unit
(type power)

(7) electric log No
(yes or no)

_____ (organization running log)

(8) how well bottom plugged Steel cap

DRILLERS REMARKS:


CODED

DEPT. OF NATURAL RESOURCES
BUREAU OF LAND & WATER RESOURCES

SEP 12 1984
RECEIVED

If well telescopes please sketch and show depths.

GROUND LEVEL

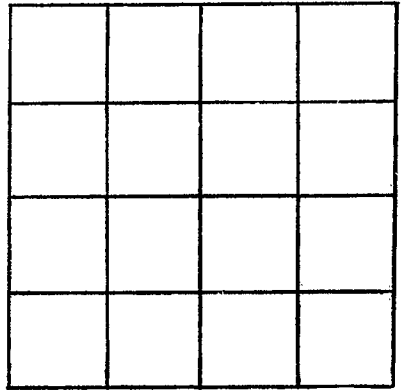

SECTION _____

Please indicate well location X.

ADDITIONAL INFORMATION

If more than one screen,
show locations of each on sketch.