

MISSISSIPPI DEPARTMENT OF NATURAL RESOURCES

Bureau of Land and Water Resources

Southport Mall

P.O. Box 10631

Jackson, Mississippi 39209

WATER WELL DRILLERS LOG

CODED

TUNICA
Q 39

6-25-84 19 Hester Drill Tunica
date well completed firm name county well located

LANDOWNER: <u>SCOTT ARNOLD</u>	description of formations encountered	from	to
<u>Farms</u> <u>Tunica, MISS</u> (mailing address)			
WELL LOCATION: sec. <u>15</u> T. <u>5</u> N R. <u>4</u> E <u>10</u> miles <u>S</u> of <u>Tunica</u> (distance) (direction) (nearest town)	<u>Gumbo</u> <u>Fine Sand</u> <u>Course Sand +</u> <u>Gravel</u>	<u>0</u>	<u>45</u> <u>45</u> <u>56</u> <u>106</u>
WELL PURPOSE: (home, irrigation, municipal, industrial)			
WELL COMPLETION DATA: (1) diameter (inches) <u>12</u> (2) total depth (feet) <u>106</u> (3) static water level (feet) <u>13</u> below above top of ground. (4) casing <u>Steel, 66</u> (material) (depth) _____ if telescope see back. (size) (5) screen <u>40, 66</u> (length) (depth to top) <u>12, Steel</u> (size) (material) (6) pump <u>60, 2000</u> (HP) (yield gpm) <u>Power Unit</u> (type power) (7) electric log <u>N/D</u> (yes or no) _____ (organization running log) (8) how well bottom plugged <u>Steel Cap</u>			
DRILLERS REMARKS:			

CODED


DEPT. OF NATURAL RESOURCES
BUREAU OF LAND & WATER RESOURCES

SEP 12 1984

RECEIVED

If well telescopes please sketch and show depths.

GROUND LEVEL

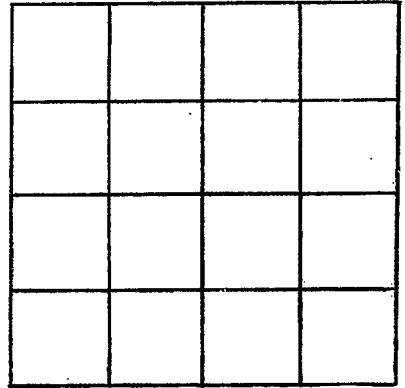

SECTION _____

Please indicate well location X.

ADDITIONAL INFORMATION

If more than one screen,
show locations of each on sketch.