

MISSISSIPPI DEPARTMENT OF NATURAL RESOURCES

Bureau of Land and Water Resources

Southport Mall

P.O. Box 10631

Jackson, Mississippi 39209

CODED

WATER WELL DRILLERS LOG

Junica
EG 118
8/28/82

8-28 1982 Hester Dilling Junica
 date well completed firm name county well located

LANDOWNER: Chas L Berry

description of formations encountered from to

Farms
Junica, Miss
 (mailing address)

<u>Junica</u>	<u>0</u>	<u>32</u>
<u>Soft Mud</u>	<u>32</u>	<u>58</u>
<u>Thin Sand</u>	<u>58</u>	<u>64</u>
<u>Coarse Sand</u>	<u>64</u>	<u>112</u>
<u>+ Gravel</u>		

WELL LOCATION:
28 T 5 N R 11 E
5 1/2 miles SE of Junica
 (distance) (direction) (nearest town)

WELL PURPOSE: Dom
 (home, irrigation, municipal, industrial)

WELL COMPLETION DATA:

CODED

- (1) diameter (inches) 12"
- (2) total depth (feet) 112"
- (3) static water level (feet) 18 below above top of ground.
- (4) casing Steel, 72 Ft
 (material) (depth)
No of telescope see back.
 (size)
- (5) screen 40, 72
 (length) (depth to top)
12" Drop Screen
 (size) (material)
- (6) pump 20 1600
 (HP) (yield gpm)
Elect
 (type power)
- (7) electric log NO
 (yes or no)
NO
 (organization running log)

(8) how well bottom plugged Steel

DRILLERS REMARKS:


DEPT. OF NATURAL RESOURCES
 BUREAU OF LAND & WATER RESOURCES

SEP 30 1982

RECEIVED

If well telescopes please sketch and show depths.

GROUND LEVEL

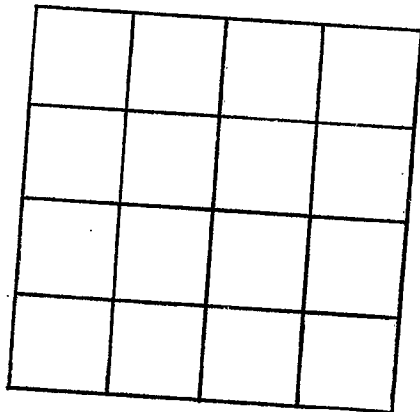

SECTION _____

Please indicate well location X.

ADDITIONAL INFORMATION

If more than one screen, show locations of each on sketch.